
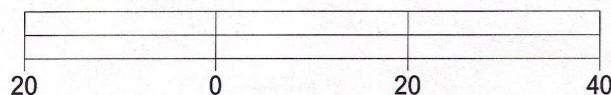


LINDA TONGE
KEEFE REAL ESTATE
LAKE GENEVA, WI.

- OF -

LOT F2 IN ADDITION "F" OF COUNTRY CLUB ESTATES, LOCATED IN THE VILLAGE OF FONTANA- ON -GENEVA-LAKE, WALWORTH COUNTY, WISCONSIN.

PATHFINDER SURVEYING INC.
(formerly)
J.K. SURVEYING INC.
P.O BOX 322
LAKE GENEVA, WI. 53147
WWW.PATHFINDERSURVEYING.NET
262-248-8303

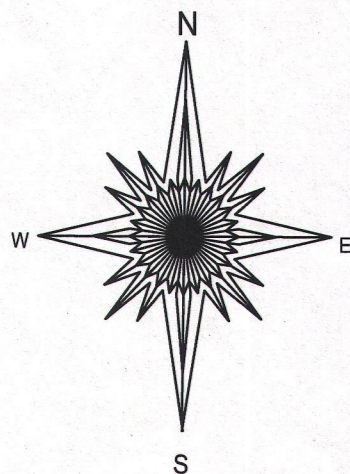


BASIS OF BEARING OF THIS PLAT: THE SUBDIVISION
PLAT OF RECORD, THE WEST LINE OF TIMBER TR.
WAS ASSUMED TO BEAR N 12°01' W.

- () = RECORDED AS
 □ = FOUND IRON BAR
 ○ = FOUND IRON PIPE
 ■ = SET IRON BAR
 ● = SET IRON PIPE

SCALE: 1" = 20'



JOB #: 04-229UD

TAX ID #: SCTF 00002

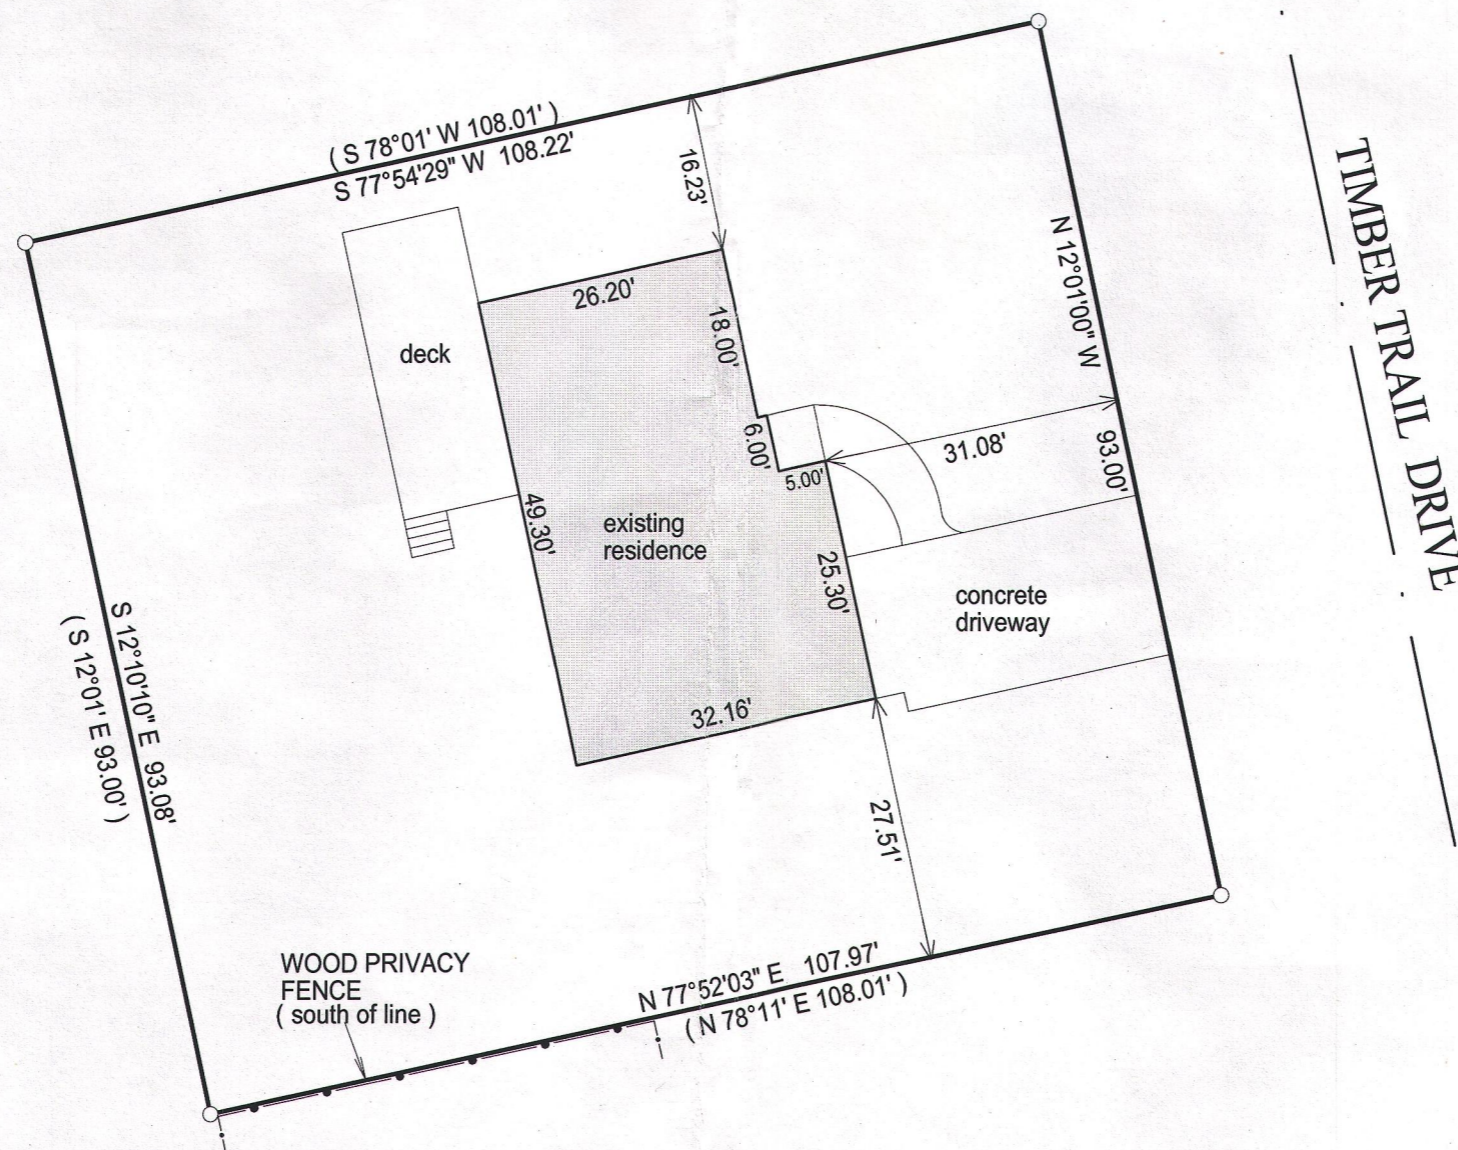

"I hereby certify that I have surveyed the above described property and that the above map, to the best of my knowledge and belief, is a true representation thereof and shows the size and location of all visible structures, apparent easements and encroachments if any."

This survey is made for the present owners of the property, and those who purchase, mortgage, or guarantee the title thereto, within one year from the date hereof.

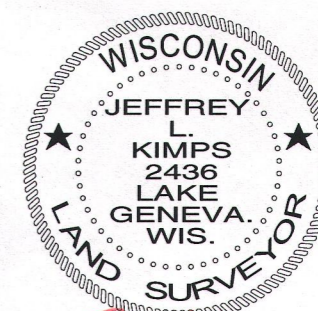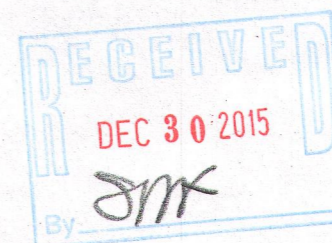

JEFFREY L KIMPS S - 2436
Wisconsin Registered Land Surveyor
(original if signed in red)

DATED THIS 16TH DAY OF SEPTEMBER, 2015.

005-3196