PREPARED FOR JOHNA. O'LAUGHLIN KEEFE REAL ESTATE LAKE GENEVA WI


PLAT OF SURVEY

- OF -

UNIT 162 ABBEY SPRINGS , A CONDOMINIUMM LOCATED IN THE SW 1/4 OF THE SW 1/4 OF SECTION 18, TOWN 1 NORTH, RANGE 17 EAST, VILLAGE OF FONTANA-ON-GENEVA LAKE, WALWORTH COUNTY, WISCONSIN.

PATHFINDER SURVEYING INC. (formerly) J.K. SURVEYINĞ INC. P.O BOX 322 LAKE GENEVA, WI. 53147 WWW.PATHFINDERSURVEYING.NET 262-248-8303

(original if signed in red)

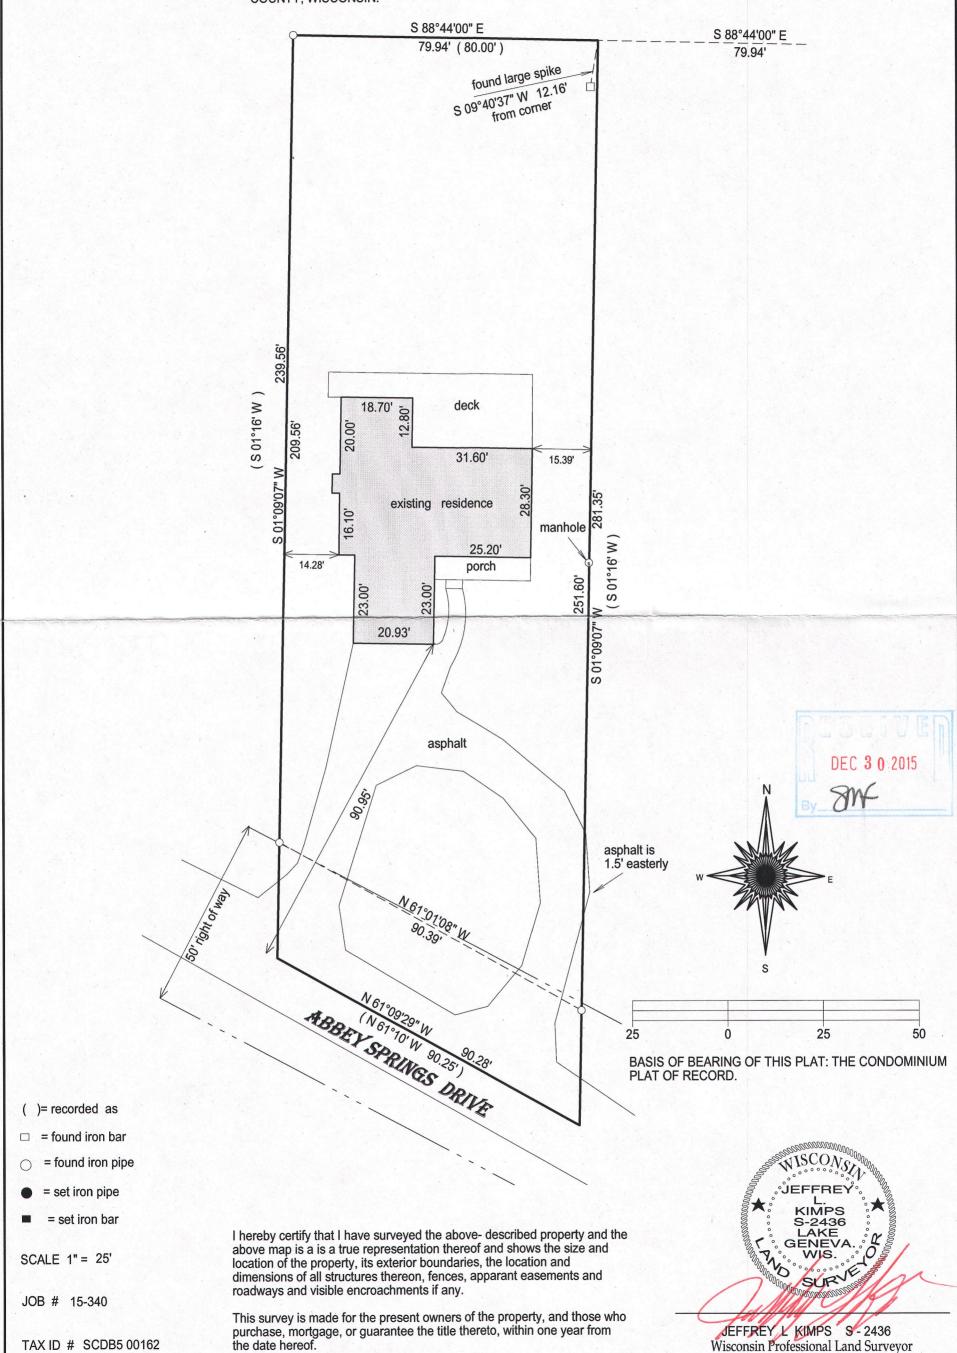

DATED THIS 26TH DAY OF OCTOBER, 2015.