



FARRIS, HANSEN & ASSOCIATES, INC.

ENGINEERING – ARCHITECTURE – SURVEYING
 7 RIDGWAY COURT – P.O. BOX 437 – ELKHORN, WISCONSIN 53121
 PHONE: (262) 723-2098 FAX: (262) 723-5886

PLAT OF SURVEY

LOT 6, ADD. "A" TO COUNTRY CLUB ESTATES
 PART OF THE SOUTH 1/2 SECTION 14
 TOWN 1 NORTH, RANGE 16 EAST
 VILLAGE OF FONTANA-ON-GENEVA LAKE
 WALWORTH COUNTY, WISCONSIN


– WORK ORDERED BY –
 HARRY SOLING
 1001 KINGSMILL ROAD
 ALGONQUIN, IL. 60102

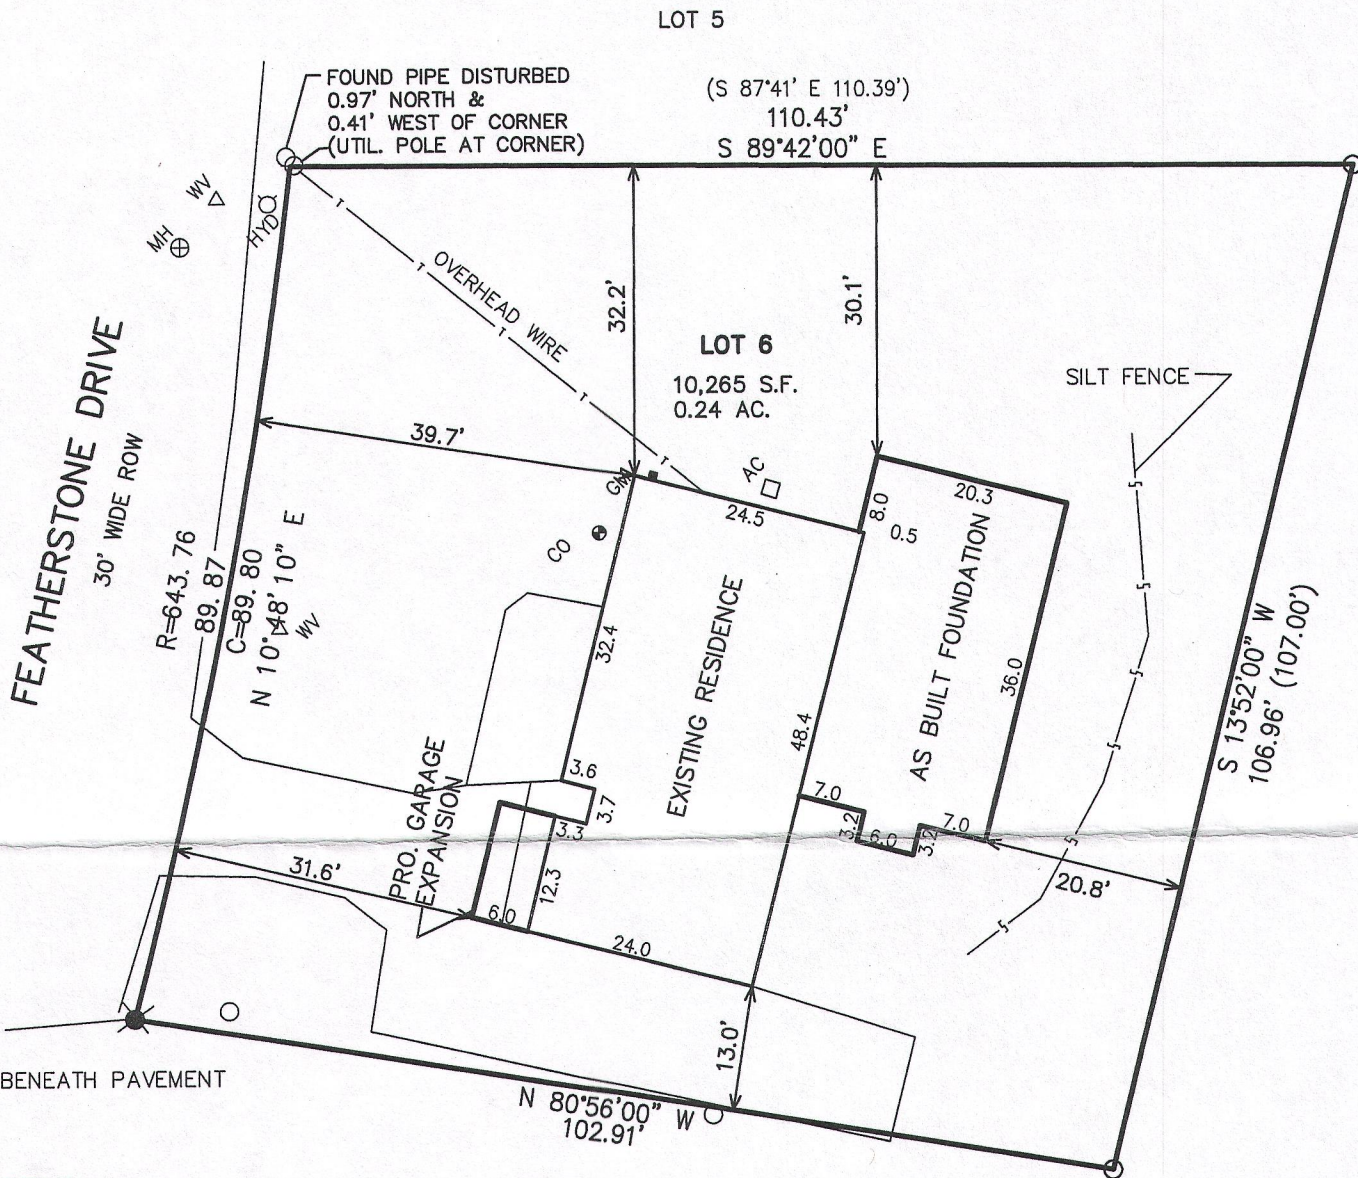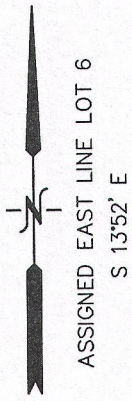

SET MAG NAIL IN
 DRIVE APRON
 METAL SOUNDED BENEATH PAVEMENT

LEGEND

- = FOUND IRON PIPE STAKE
- = SET IRON REBAR STAKE
- (XXX) = RECORDED AS

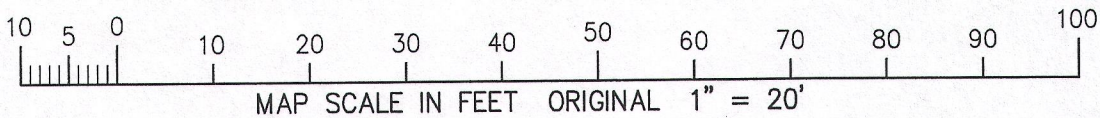

OVERALL AREA = 10,265 S.F.
 ORIGINAL GREEN SPACE = 72% (28% IMPERVIOUS)
 AFTER ADDITION 66% GREEN SPACE (34% IMPERVIOUS)



NOTE: COPIES OF THIS MAP TO WHICH THE FOLLOWING CERTIFICATE WILL APPLY SHOW THE SURVEYOR'S ORIGINAL SEAL AND SIGNATURE IN RED INK. COPIES BY ANY OTHER MEANS MAY HAVE ALTERATIONS WHICH DO NOT REPRESENT THE SURVEYOR'S WORK PRODUCT.

I HEREBY CERTIFY THAT THE ABOVE DESCRIBED PROPERTY HAS BEEN SURVEYED UNDER MY DIRECTION AND THAT THE ABOVE MAP IS A TRUE REPRESENTATION THEREOF AND SHOWS THE SIZE AND LOCATION OF THE PROPERTY AND ITS EXTERIOR BOUNDARIES. THIS SURVEY IS MADE FOR THE USE OF THE PRESENT OWNERS OF THE PROPERTY, AND ALSO THOSE WHO PURCHASE, MORTGAGE, OR GUARANTEE THE TITLE THERETO WITHIN ONE YEAR FROM THE DATE HEREOF.

DATED: DECEMBER 22, 2015

REVISED 02-10-2016
 TO SHOW SIZE & LOCATION OF
 AS BUILT ADDITION FOUNDATION

Peter S. Gordon
 PETER S. GORDON P.L.S. 2101

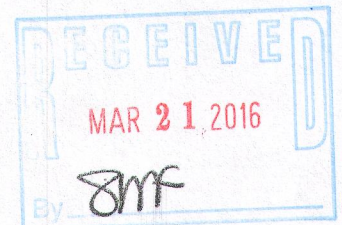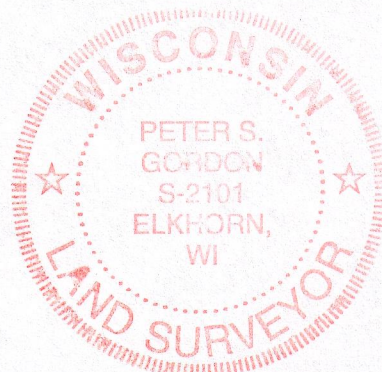

PROJECT: 9438
 DATE: 12-22-2015
 SHEET 1 OF 1

X:\Projects\9438\dcad\survey

SCTA-6
 FEB 10 2016

005-3222