



# FARRIS, HANSEN & ASSOCIATES, INC.

ENGINEERING – ARCHITECTURE – SURVEYING  
 7 RIDGWAY COURT – P.O. BOX 437 – ELKHORN, WISCONSIN 53121  
 PHONE: (262) 723-2098 FAX: (262) 723-5886

## PLAT OF SURVEY

LOT 6, ADD. "A" TO COUNTRY CLUB ESTATES  
 PART OF THE SOUTH 1/2 SECTION 14  
 TOWN 1 NORTH, RANGE 16 EAST  
 VILLAGE OF FONTANA-ON-GENEVA LAKE  
 WALWORTH COUNTY, WISCONSIN


– WORK ORDERED BY –  
 HARRY SOLING  
 1001 KINGSMILL ROAD  
 ALGONQUIN, IL. 60102

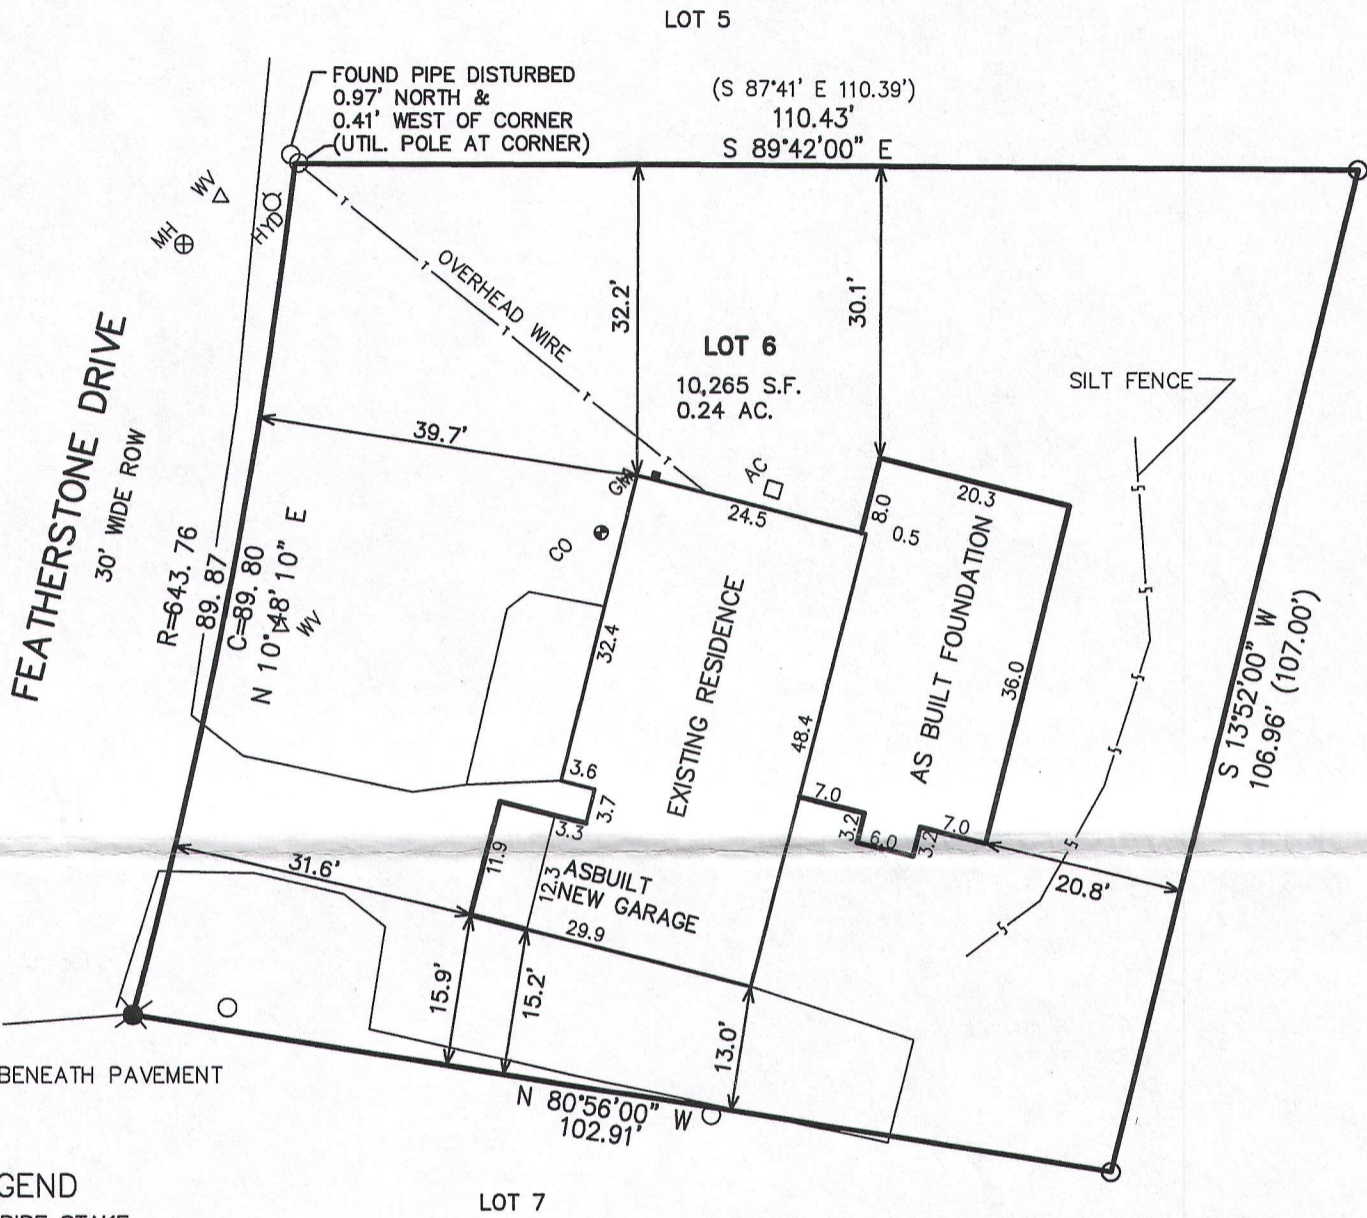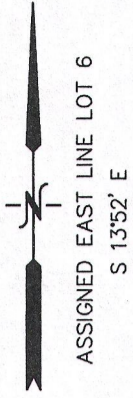

SET MAG NAIL IN  
 DRIVE APRON  
 METAL SOUNDED BENEATH PAVEMENT

### LEGEND



- = FOUND IRON PIPE STAKE
- = SET IRON REBAR STAKE
- (XXX) = RECORDED AS

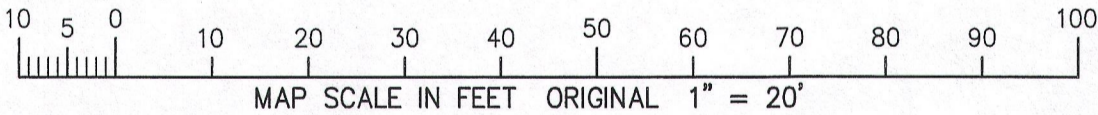

OVERALL AREA = 10,265 S.F.  
 ORIGINAL GREEN SPACE = 72% (28% IMPERVIOUS)  
 AFTER ADDITION 66% GREEN SPACE (34% IMPERVIOUS)

NOTE: COPIES OF THIS MAP TO WHICH THE FOLLOWING CERTIFICATE WILL APPLY SHOW THE SURVEYOR'S ORIGINAL SEAL AND SIGNATURE IN RED INK. COPIES BY ANY OTHER MEANS MAY HAVE ALTERATIONS WHICH DO NOT REPRESENT THE SURVEYOR'S WORK PRODUCT.

I HEREBY CERTIFY THAT THE ABOVE DESCRIBED PROPERTY HAS BEEN SURVEYED UNDER MY DIRECTION AND THAT THE ABOVE MAP IS A TRUE REPRESENTATION THEREOF AND SHOWS THE SIZE AND LOCATION OF THE PROPERTY AND ITS EXTERIOR BOUNDARIES. THIS SURVEY IS MADE FOR THE USE OF THE PRESENT OWNERS OF THE PROPERTY, AND ALSO THOSE WHO PURCHASE, MORTGAGE, OR GUARANTEE THE TITLE THERETO WITHIN ONE YEAR FROM THE DATE HEREOF.

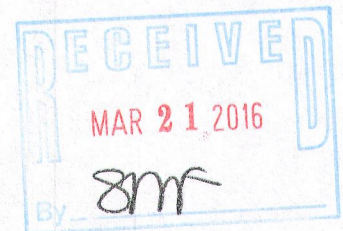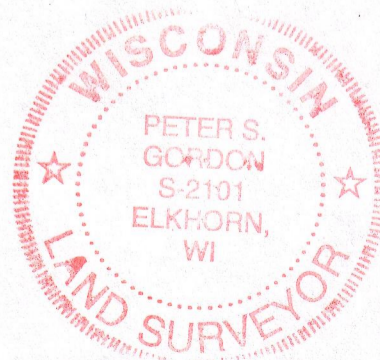

DATED: DECEMBER 22, 2015

REVISED 02-10-2016  
 TO SHOW SIZE & LOCATION OF  
 AS BUILT ADDITION FOUNDATION

REVISED 03-08-2016  
 TO SHOW SIZE & LOCATION OF  
 NEW ATTACHED GARAGE

*Peter S. Gordon*  
 PETER S. GORDON P.L.S. 2101

PROJECT: 9438  
 DATE: 12-22-2015  
 SHEET 1 OF 1

X: \Projects\9438\docd\survey

3/8/2016

SCTA  
 MAR 08 2016

005-3224