


GEORGE T. DUNHAM  
SURVEYING & SUBDIVIDING  
DELAVAN, WISCONSIN

L A K E  
G E N E V A

P A R K

N

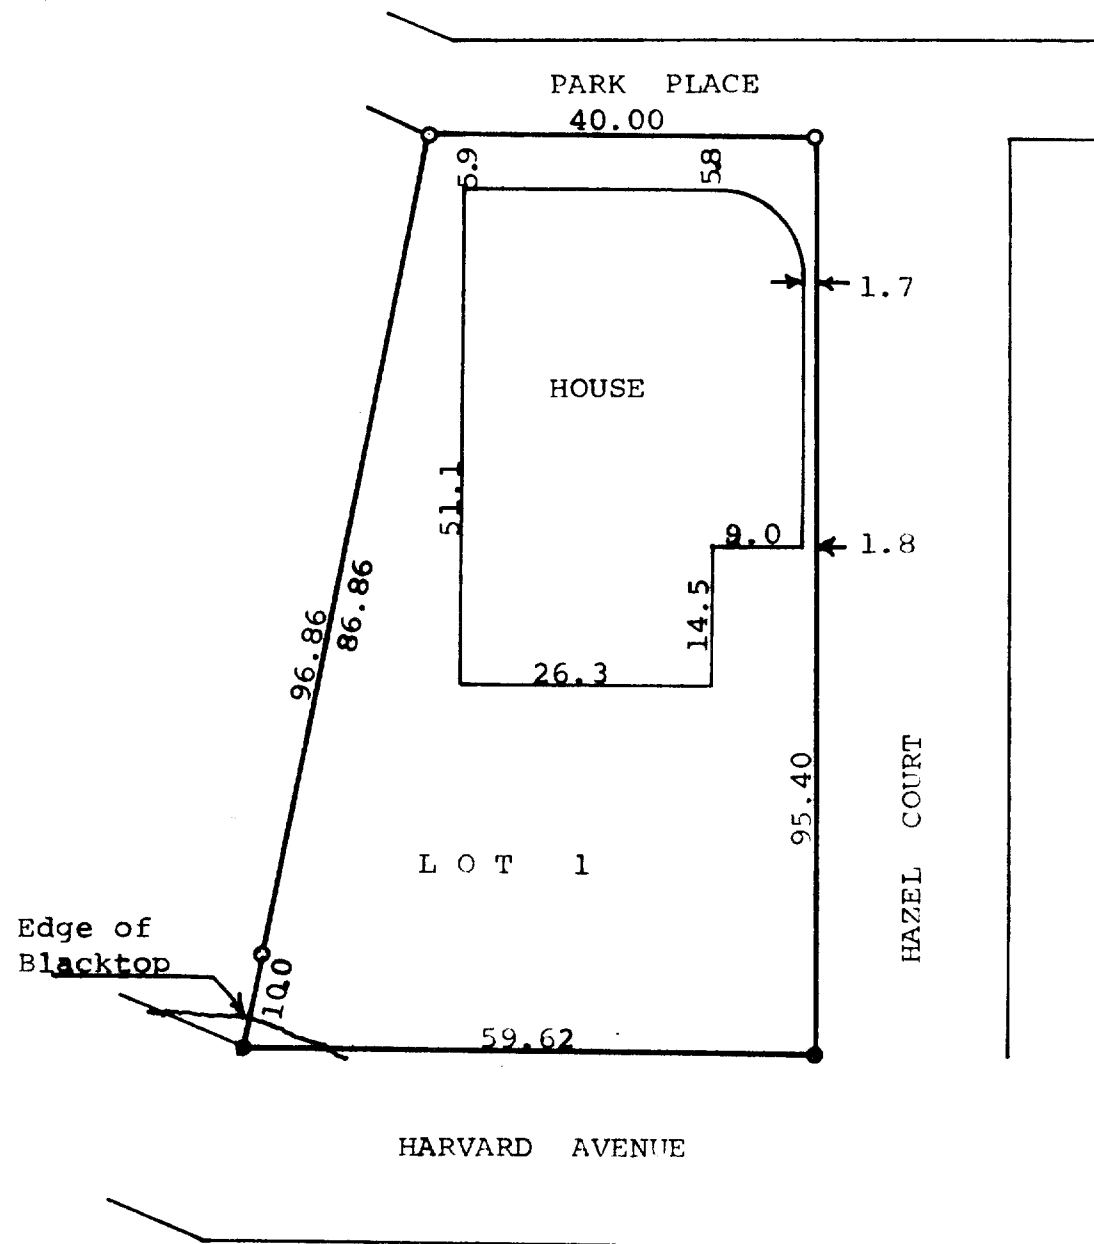

Scale - 1" = 20'

- = Concrete Monument
- = Iron Pipe

STATE OF WISCONSIN)  
COUNTY OF WALWORTH) SS

I George T. Dunham, Surveyor, certify that I have surveyed the property described as follows,  
Lot 1, Block 17 of Glenwood Springs, a subdivision located in the Village of Fontana, Walworth County, Wisconsin,  
and that the above plat is an accurate survey and a true representation thereof and correctly shows the exterior boundary lines and location of buildings on said property and the correct measurements thereof.  
June 1, 1973

*George T. Dunham*  
George T. Dunham, Surveyor

