



FILE NO. _____

Street address: 393 Lake Shore Drive, Fontana, Wisconsin.

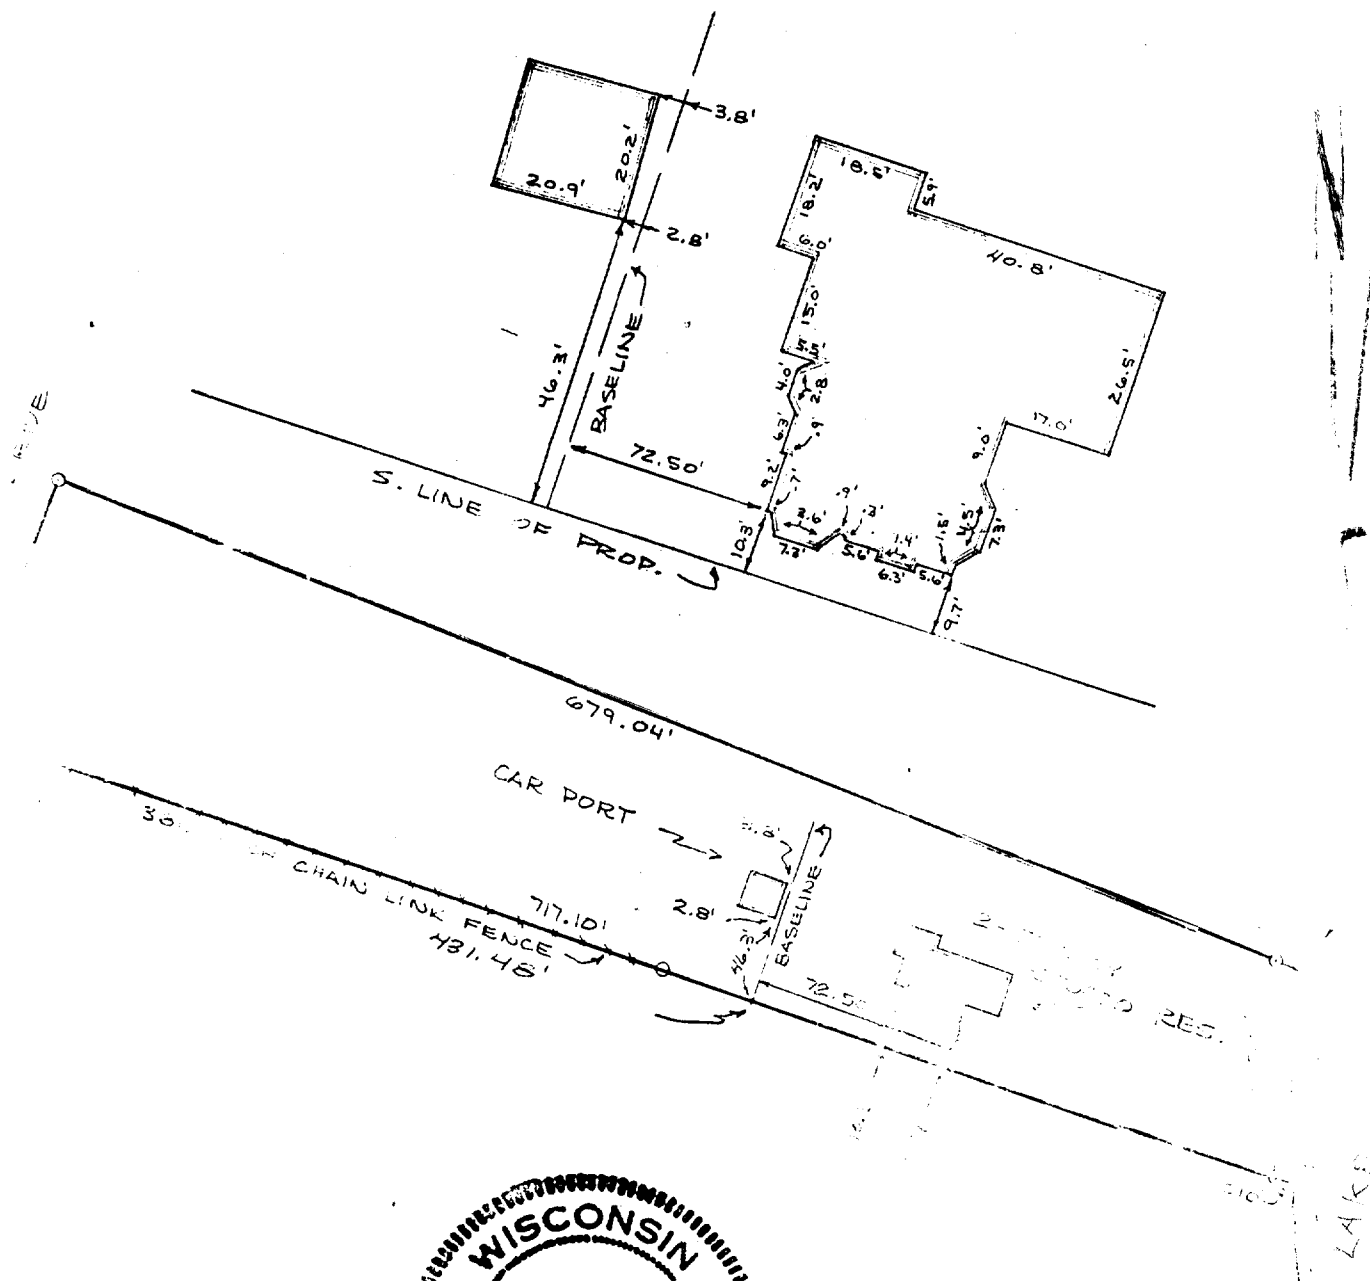

BASE:

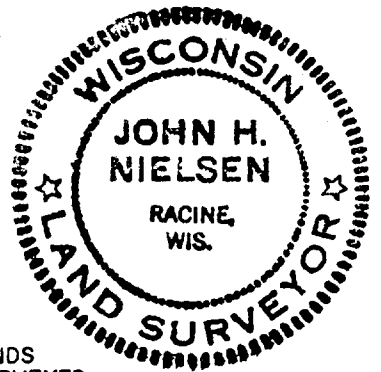

● = 3/4" DIA. IRON PIPE
○ = IRON STAKE FOUND

SIGNED Em. D. Jones S-338

SCALE: 1" = 100'

JOB NO. NM-1337