




PREPARED FOR:
GENEVA LAKEFRONT REALTY

PLAT OF SURVEY

- OF -

PATHFINDER SURVEYING INC.
(formerly)
J.K. SURVEYING INC.
P.O BOX 322
LAKE GENEVA, WI. 53147
262-248-8303

LOTS 1 AND 2, BLOCK 14 OF GLENWOOD SPRINGS, LOCATED IN THE
VILLAGE OF FONTANA-ON-GENEVA, WALWORTH COUNTY, WISCONSIN

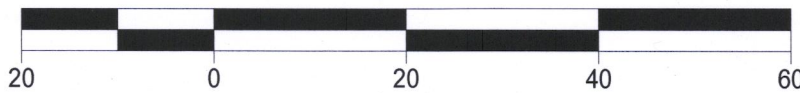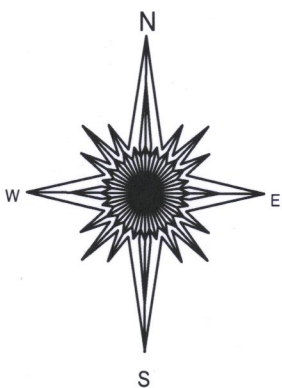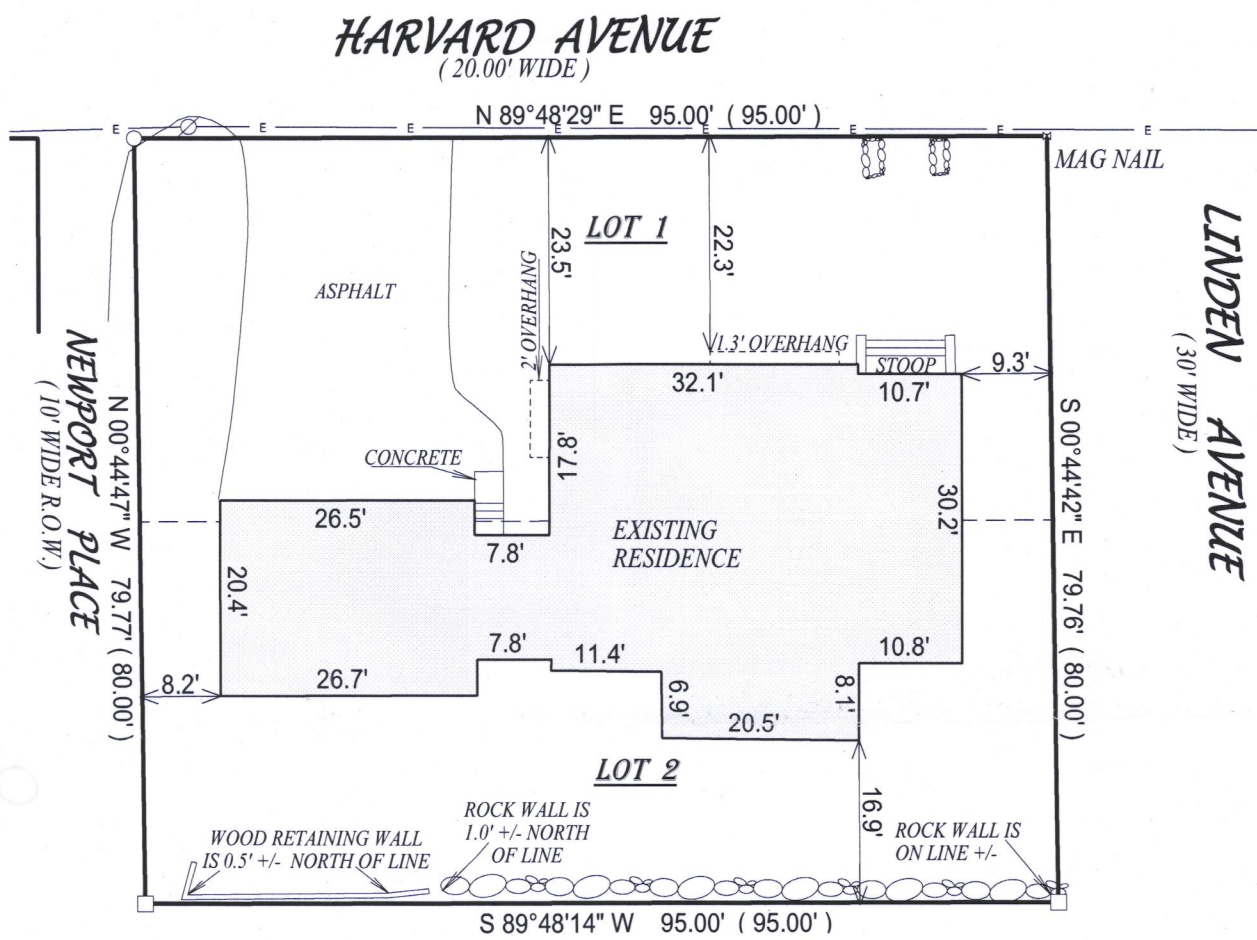

NOTE: DUE TO HEAVY SNOW COVER
ALL IMPROVEMENTS MAY NOT
BE SHOWN.

NOTE: BASIS OF BEARING IS HARVARD
AVENUE IS ASSUMED TO BEAR "N 89°48'29" E",
AS MONUMENTED.

"I hereby certify that I have surveyed the above described property and that the above map, to the best of my knowledge and belief, is a true representation thereof and shows the size and location of all visible structures, apparent easements and encroachments if any." This survey is made for the present owners of the property, and those who purchase, mortgage, or guarantee the title thereto, within one year from the date hereof.

DATED THIS 21ST DAY OF DECEMBER, 2016.

- ⊗ = UTILITY POLE
- = OVERHEAD UTILITIES
- () = RECORDED AS
- = FOUND IRON BAR
- = FOUND IRON PIPE
- = SET IRON BAR
- = SET IRON PIPE

SCALE: 1" = 20'

JOB #: 09-067 / 2016

TAX ID # (SGS 00082)



JEFFREY L. KIMPS S-2436
Wisconsin Professional Land Surveyor
(original if signed in red)

005 - 3334