


PREPARED FOR
BOB WEBSTER
KEEFE REAL ESTATE
LAKE GENEVA WI.

PLAT OF SURVEY


PATHFINDER SURVEYING INC.
(formerly)
J.K. SURVEYING INC.
P.O. BOX 322
LAKE GENEVA, WI. 53147
WWW.PATHFINDERSURVEYING.NET
262-248-8303

-OF-

LOT 23, ADDITION "D" TO COUNTRY CLUB ESTATES, AS SHOWN BY PLAT THEREOF IN THE REGISTER OF DEEDS OFFICE OF WALWORTH COUNTY, RECORDED IN VOLUME 12 OF PLATS PAGE 85 ON JULY 25, 1953, VILLAGE OF FONTANA.

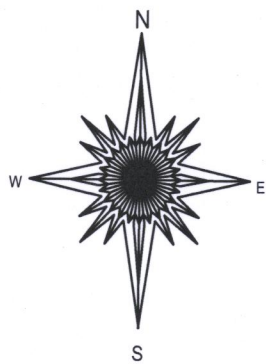

- () = RECORDED AS
- = FOUND IRON BAR
- = FOUND IRON PIPE
- = SET IRON PIPE
- = SET IRON BAR

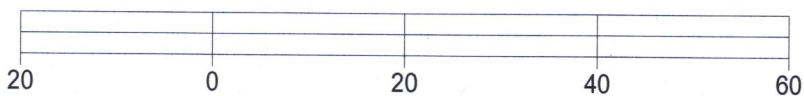

NOTE: BASIS OF BEARING IS PREVIOUS SURVEY OF RECORD

"I hereby certify that the above described property was surveyed under my supervision and that the above map, to the best of my knowledge and belief, is a true representation thereof and shows the size and location of all visible structures, apparent easements and encroachments if any." This survey is made for the present owners of the property, and those who purchase, mortgage, or guarantee the title thereto, within one year from the date hereof.

DATED THIS 10TH DAY OF MARCH, 2017.



JEFFREY L. KIMPS S-2436
Wisconsin Professional Land Surveyor
(original if signed in red)

SCD-24

005-3337