



PREPARED FOR  
BOB WEBSTER  
KEEFE REAL ESTATE  
LAKE GENEVA WI.

# PLAT OF SURVEY


-OF-

PATHFINDER SURVEYING INC.  
(formerly)  
J.K. SURVEYING INC.  
P.O BOX 322  
LAKE GENEVA, WI. 53147  
WWW.PATHFINDERSURVEYING.NET  
262-248-8303

LOT 23, ADDITION "D" TO COUNTRY CLUB ESTATES, AS SHOWN BY PLAT  
THEREOF IN THE REGISTER OF DEEDS OFFICE OF WALWORTH COUNTY,  
RECORDED IN VOLUME 12 OF PLATS PAGE 85 ON JULY 25, 1953, VILLAGE OF  
FONTANA.

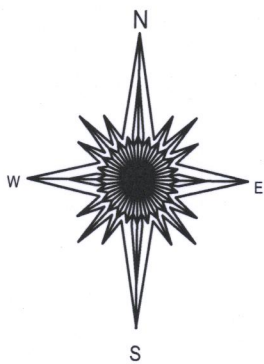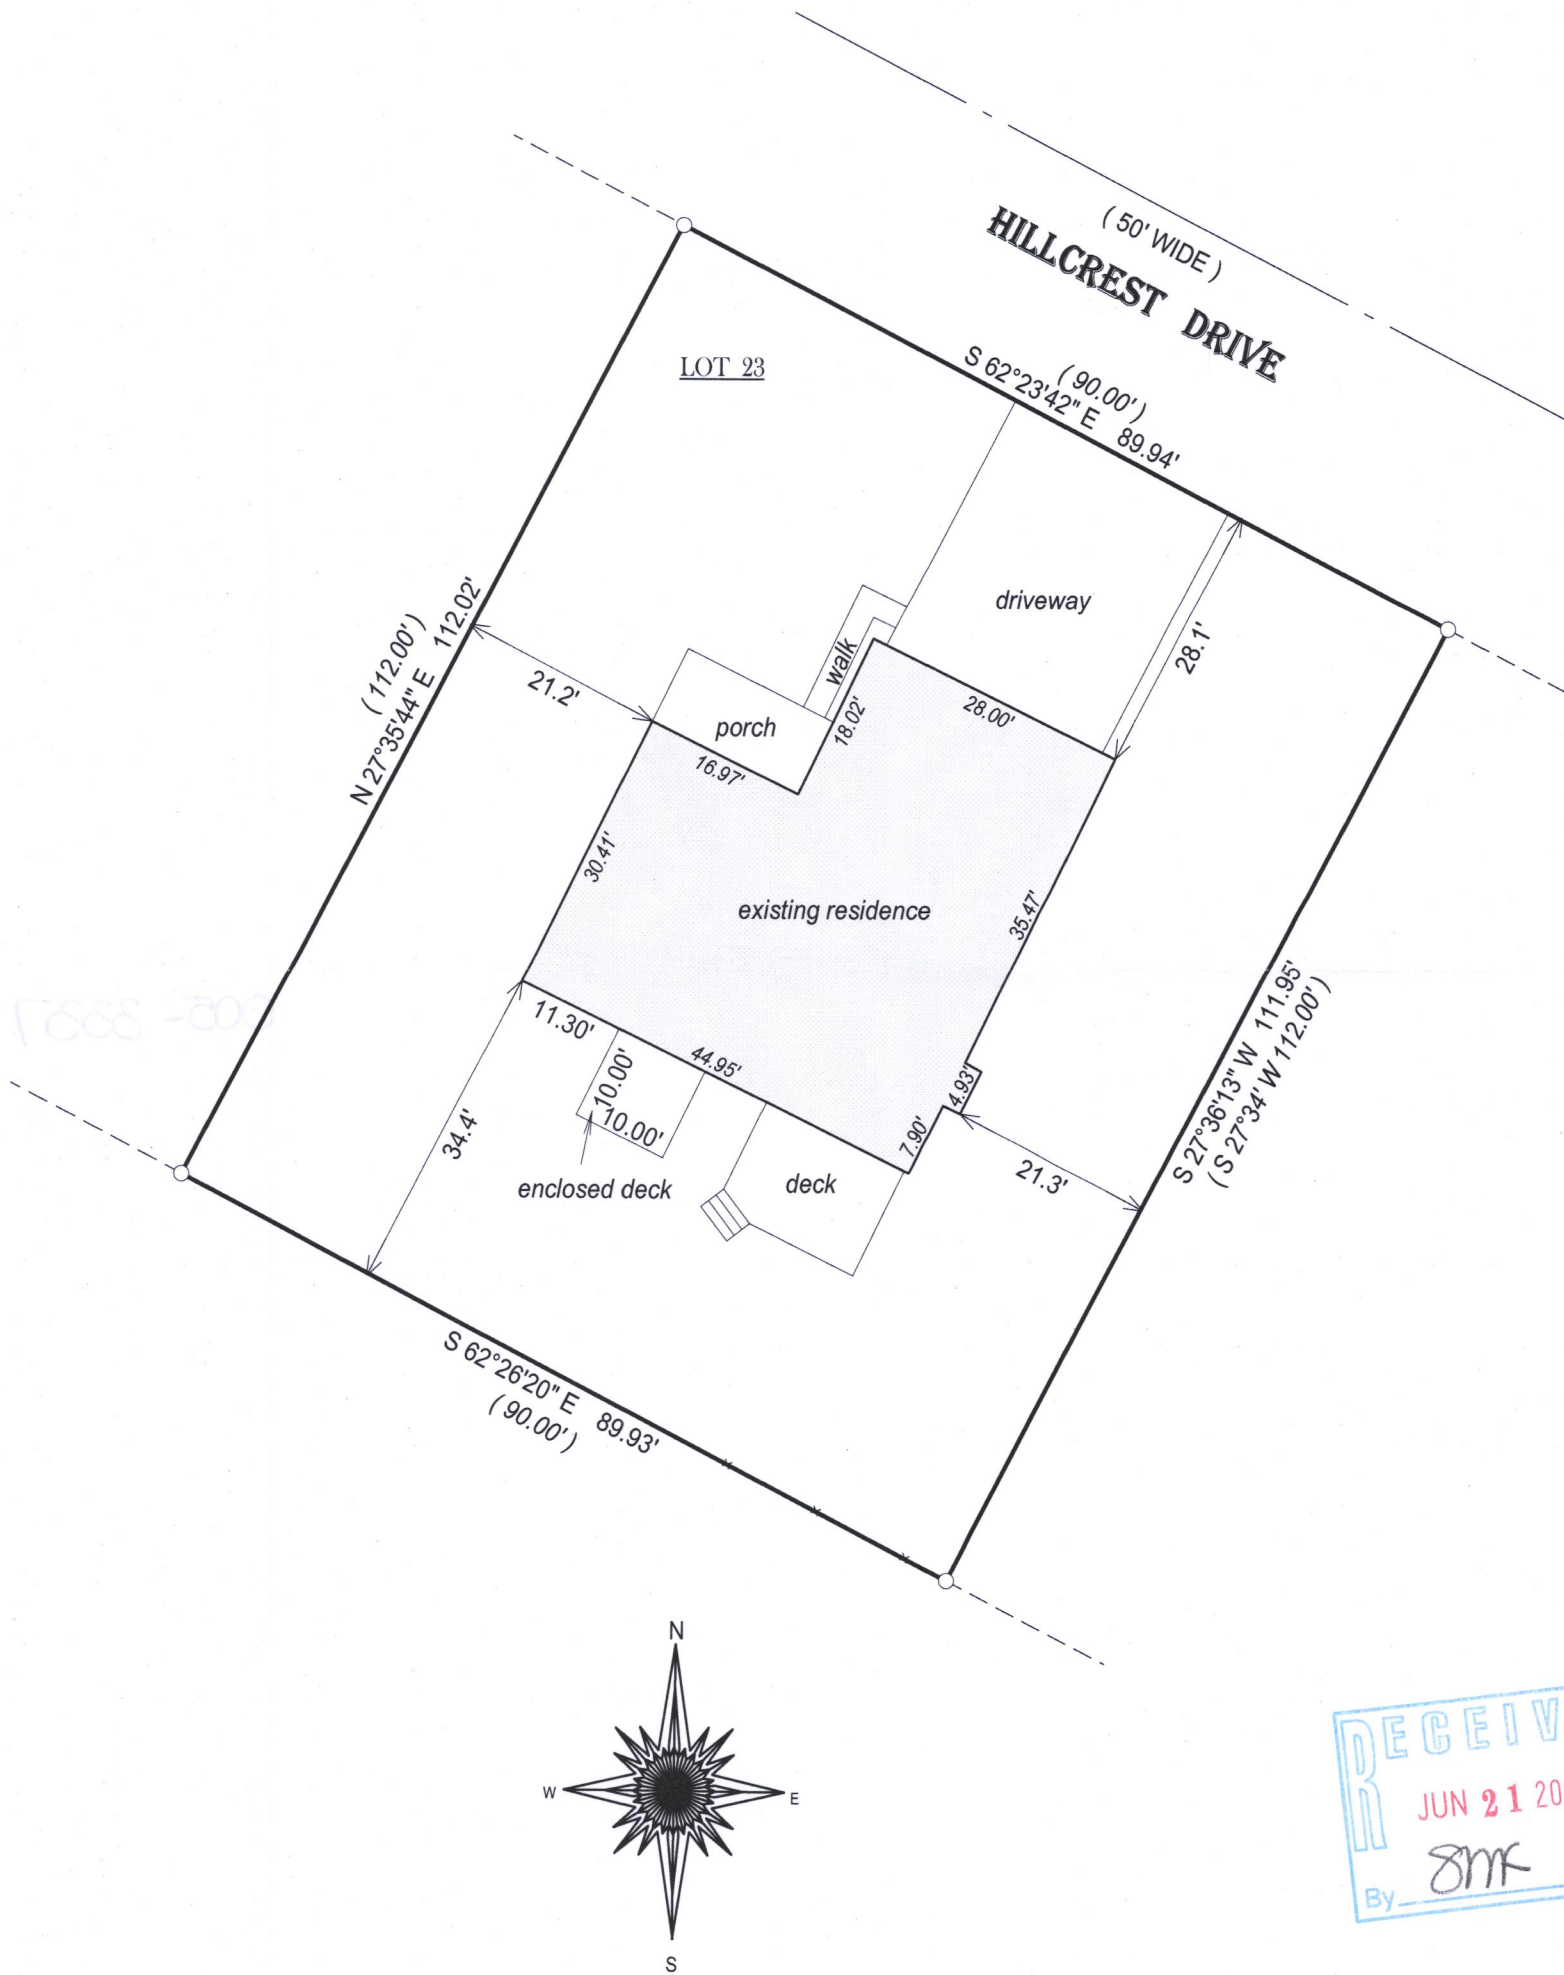

- ( ) = RECORDED AS
- = FOUND IRON BAR
- = FOUND IRON PIPE
- = SET IRON PIPE
- = SET IRON BAR

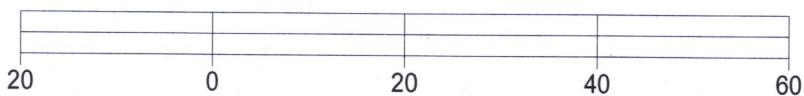

NOTE: BASIS OF BEARING IS PREVIOUS SURVEY OF RECORD

"I hereby certify that the above described property was surveyed under my supervision and that the above map, to the best of my knowledge and belief, is a true representation thereof and shows the size and location of all visible structures, apparent easements and encroachments if any."  
This survey is made for the present owners of the property, and those who purchase, mortgage, or guarantee the title thereto, within one year from the date hereof.  
DATED THIS 10TH DAY OF MARCH, 2017.



JEFFREY L. KIMPS S-2436  
Wisconsin Professional Land Surveyor  
(original if signed in red)

SCD-24

005-3337