

LAND-MARK SURVEYING

Mark L. Miritz

Wisconsin Professional Land Surveyor S-2582


N9330 Knuteson Drive
Whitewater, WI 53190
Phone: (262) 495-3284
MARKMIRITZ@
LAND-MARKSURVEYING.COM

PLAT OF SURVEY

LOT 147, COUNTRY CLUB ESTATES UNIT 2, LOCATED
IN THE SOUTHWEST 1/4 OF SECTION 14, TOWN 1 NORTH,
RANGE 16 EAST, VILLAGE OF FONTANA, WALWORTH
COUNTY, WISCONSIN.

OWNER:
TERESA DAINKO

SITE ADDRESS:
866 SAUGANASH DR.
FONTANA, WI 53125

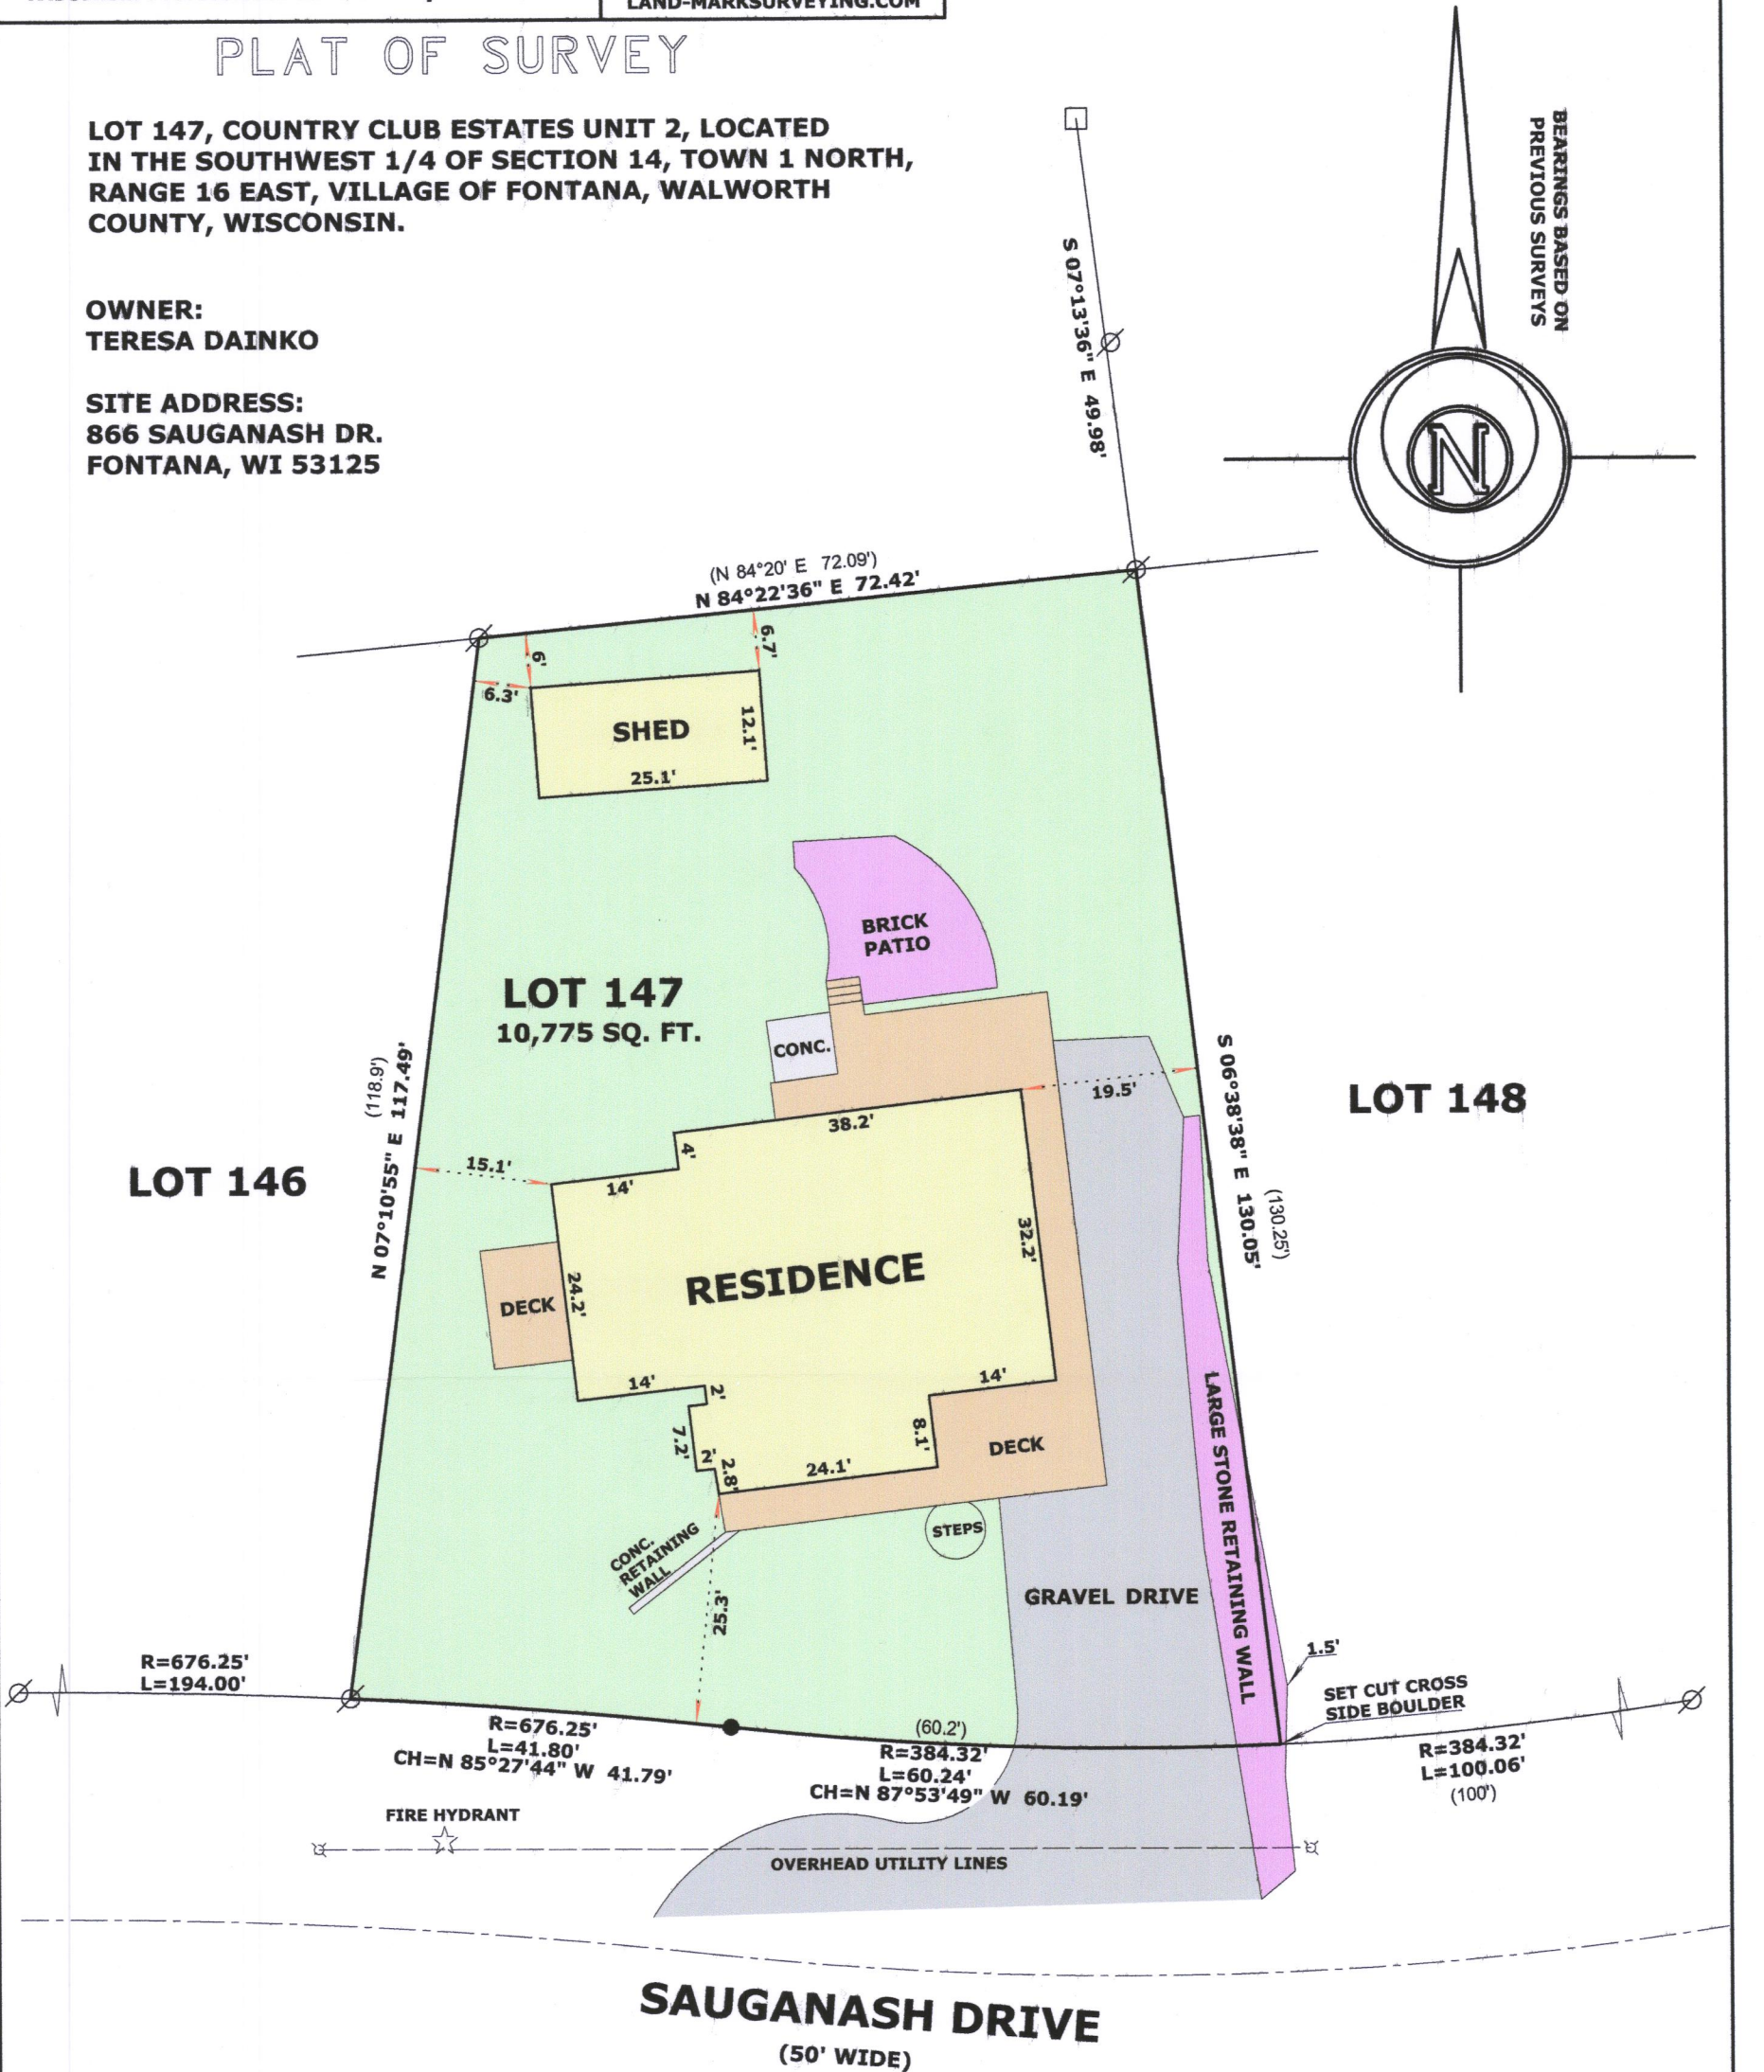

8C02-137A1

005-3342

(xx)