


PREPARED FOR  
TWIN REALTY

PLAT OF SURVEY

- OF -

LOT 11 ADDITION "E" TO COUNTRY CLUB ESTATES, IN THE VILLAGE OF  
FONTANA-ON-GENEVA-LAKE, WALWORTH COUNTY, WISCONSIN.

PATHFINDER SURVEYING  
(a NMB Company)  
P.O BOX 322  
LAKE GENEVA, WI. 53147  
WWW.PATHFINDERSURVEYING.NET  
262-248-8303

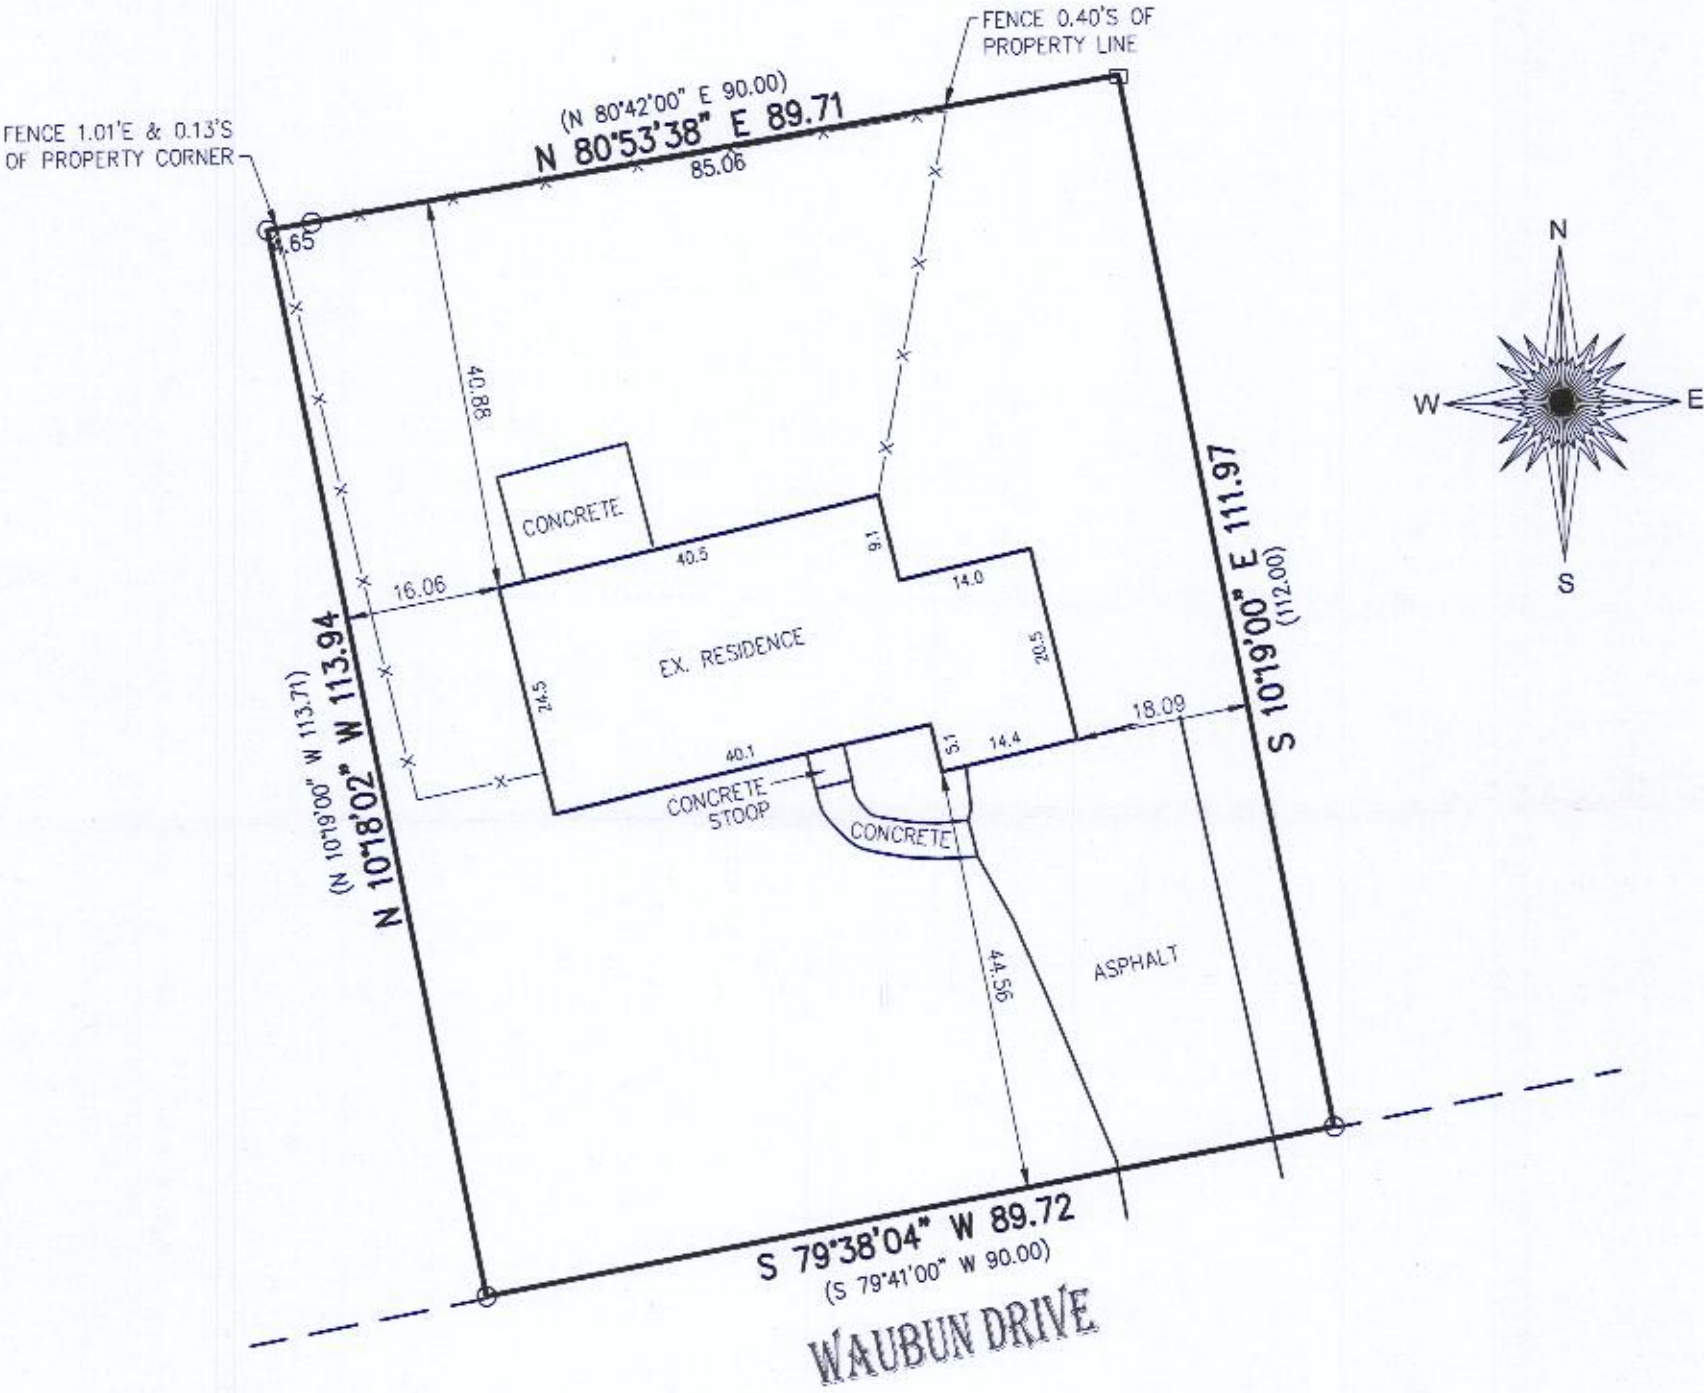

- ( ) = recorded as
- = found concrete monument
- = found iron pipe

SCALE 1" = 20'

JOB # 2018.0208.01

TAX ID # SCTE 00011

BASIS OF BEARING OF THIS PLAT: THE EAST LINE OF LOT 11 WAS  
ASSUMED TO BEAR S 10°19'00"E AS PLATTED.

I hereby certify that I have surveyed the above- described property and the  
above map is a true representation thereof and shows the size and  
location of the property, its exterior boundaries, the location and dimensions  
of all structures thereon, fences, apparent easements and roadways and  
visible encroachments if any.

This survey is made for the present owners of the property, and those who  
purchase, mortgage, or guarantee the title thereto, within one year from the  
date hereof.

DATED THIS 12TH DAY OF OCTOBER, 2017.



*Mark R. Madsen*  
MARK R. MADSEN S - 2271  
Wisconsin Professional Land Surveyor

005-3375