

AMBIT LAND SURVEYING  
8120-312th Avenue  
Wheatland, WI. 53105-8934  
Licensed Professionals in  
both Illinois & Wisconsin

PLAT OF SURVEY  
OF

PHONE: 262-537  
FAX: 262-537  
EMAIL: ambit@


Lot 18, Block 5 of ASSESSOR'S PLAT NO. 1, C. L. DOUGLAS SUBDIVISION TO THE VILLAGE OF FONTANA  
ON LAKE GENEVA, Walworth County, Wisconsin.

PARCEL IDENTIFICATION NO.: STFV 00243

The above legal description is as provided.



SCALE: 1 inch 20 feet  
ORDERED BY: M. Larkin / Keefe Real Estate  
JOB NO.: 16184

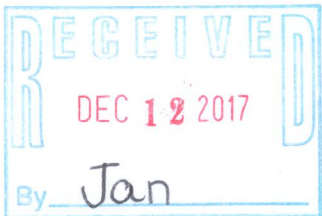

Fieldwork completed on and date of certification: September 2, 2017  
I hereby certify that I have surveyed the above described property and that the plat is a true representation thereof and shows the size and location of the property, its exterior boundaries, the location and dimensions of all structures thereon, boundary fences, apparent easements and roadways and encroachments, if any.  
This survey is made for the exclusive use of the present owners of the property and also those who purchase, mortgage or guarantee the title thereto within one year from the date hereof.  
Dated at Wheatland, Wisconsin this \_\_\_\_\_ day of \_\_\_\_\_

Mark A. Bolender  
Wisconsin Professional Land Surveyor 1784

STFV-243 005-3379