


PLAT OF SURVEY

Lot 13 in Block 1 Brookwood Subdivision, according to the Plat thereof recorded in the Office of the Register of Deeds for Walworth County, Wisconsin, Village of Fontana, Walworth County, Wisconsin.

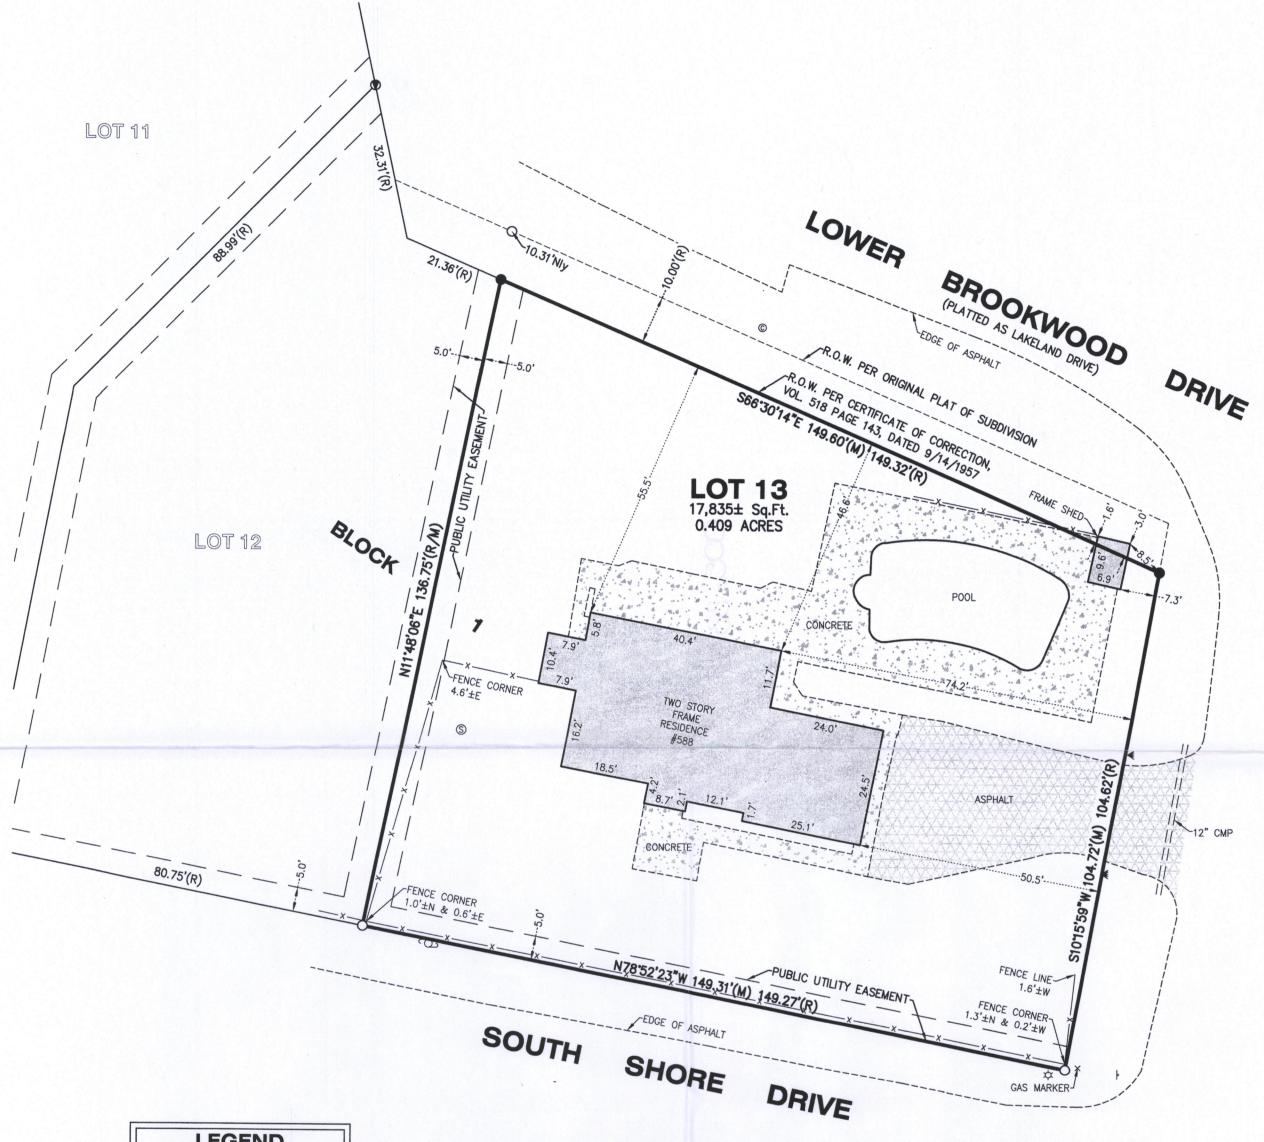

LEGEND	
©	CLEAN OUT
•	FOUND IRON BAR
0	FOUND IRON PIPE
•	FOUND RR SPIKE
\$	LIGHT
S	SEPTIC LID
•	SIGN
D	UTILITY POLE
•	YARD LIGHT
CMP	CORRUGATED METAL PIPE
(M)	MEASURED
(R)	RECORD

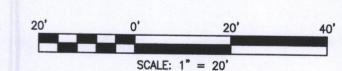

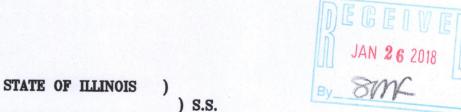

CLIENT: ALVARO COLIN

DRAWN BY: DAM CHECKED BY: APG

SCALE: 1"=20' SEC. 18 T. 01 R. 17 E.

BASIS OF BEARING: ASSUMED

P.I.N.: SBS 00013

JOB NO.: 170508 I.D. LSS

FIELDWORK COMP.: 7/11/17 BK.

ALL DISTANCES SHOWN IN FEET AND DECIMAL REF: _____

Compare your description and site markings with this plat and AT ONCE report any discrepancies which you may find.

building lines or easements.

unless shown and noted.

NOTE: Only those Building Line Restrictions or

* No distance should be assumed by scaling.

* No representation as to ownership, use,

or possession should be hereon implied.

Easements shown on a Recorded Subdivision Plat are

surveyed contains a proper description of the required

shown hereon unless the description ordered to be

* No underground improvements have been located

* This Survey and Plat of Survey are void without

original embossed or colored seal and signature

COUNTY OF McHENRY)

In my professional opinion, and based on my observations, I hereby certify that the above described property has been surveyed under my direction and that the above map is a true representation thereof and shows the size and location of all visible structures, and dimensions of all principle buildings thereon, boundary fences, apparent easements, roadways, and visible encroachments, if any. This survey is made for the use of the present owners of the property, and also those who purchase, mortgage, or guarantee the title thereto within one year from the date hereof.

Dated at Woodstock, McHenry County, Illinois 7/18 A.D., 20 17.

Vanderstappen Land Surveying, Inc.

Design Firm No. 184-002792

By: Wisconsin Registered Land Surveyor No. S3021