


PLAT OF SURVEY

OF LOT 16, BLOCK 12, GLENWOOD SPRINGS SUBDIVISION,
BEING PART OF THE EAST 1/2 OF SECTION 14, T. 1 N., R. 16 E.,
OF THE 4TH P.M., VILLAGE OF FONTANA-ON-GENEVA LAKE,
WALWORTH COUNTY, WISCONSIN.

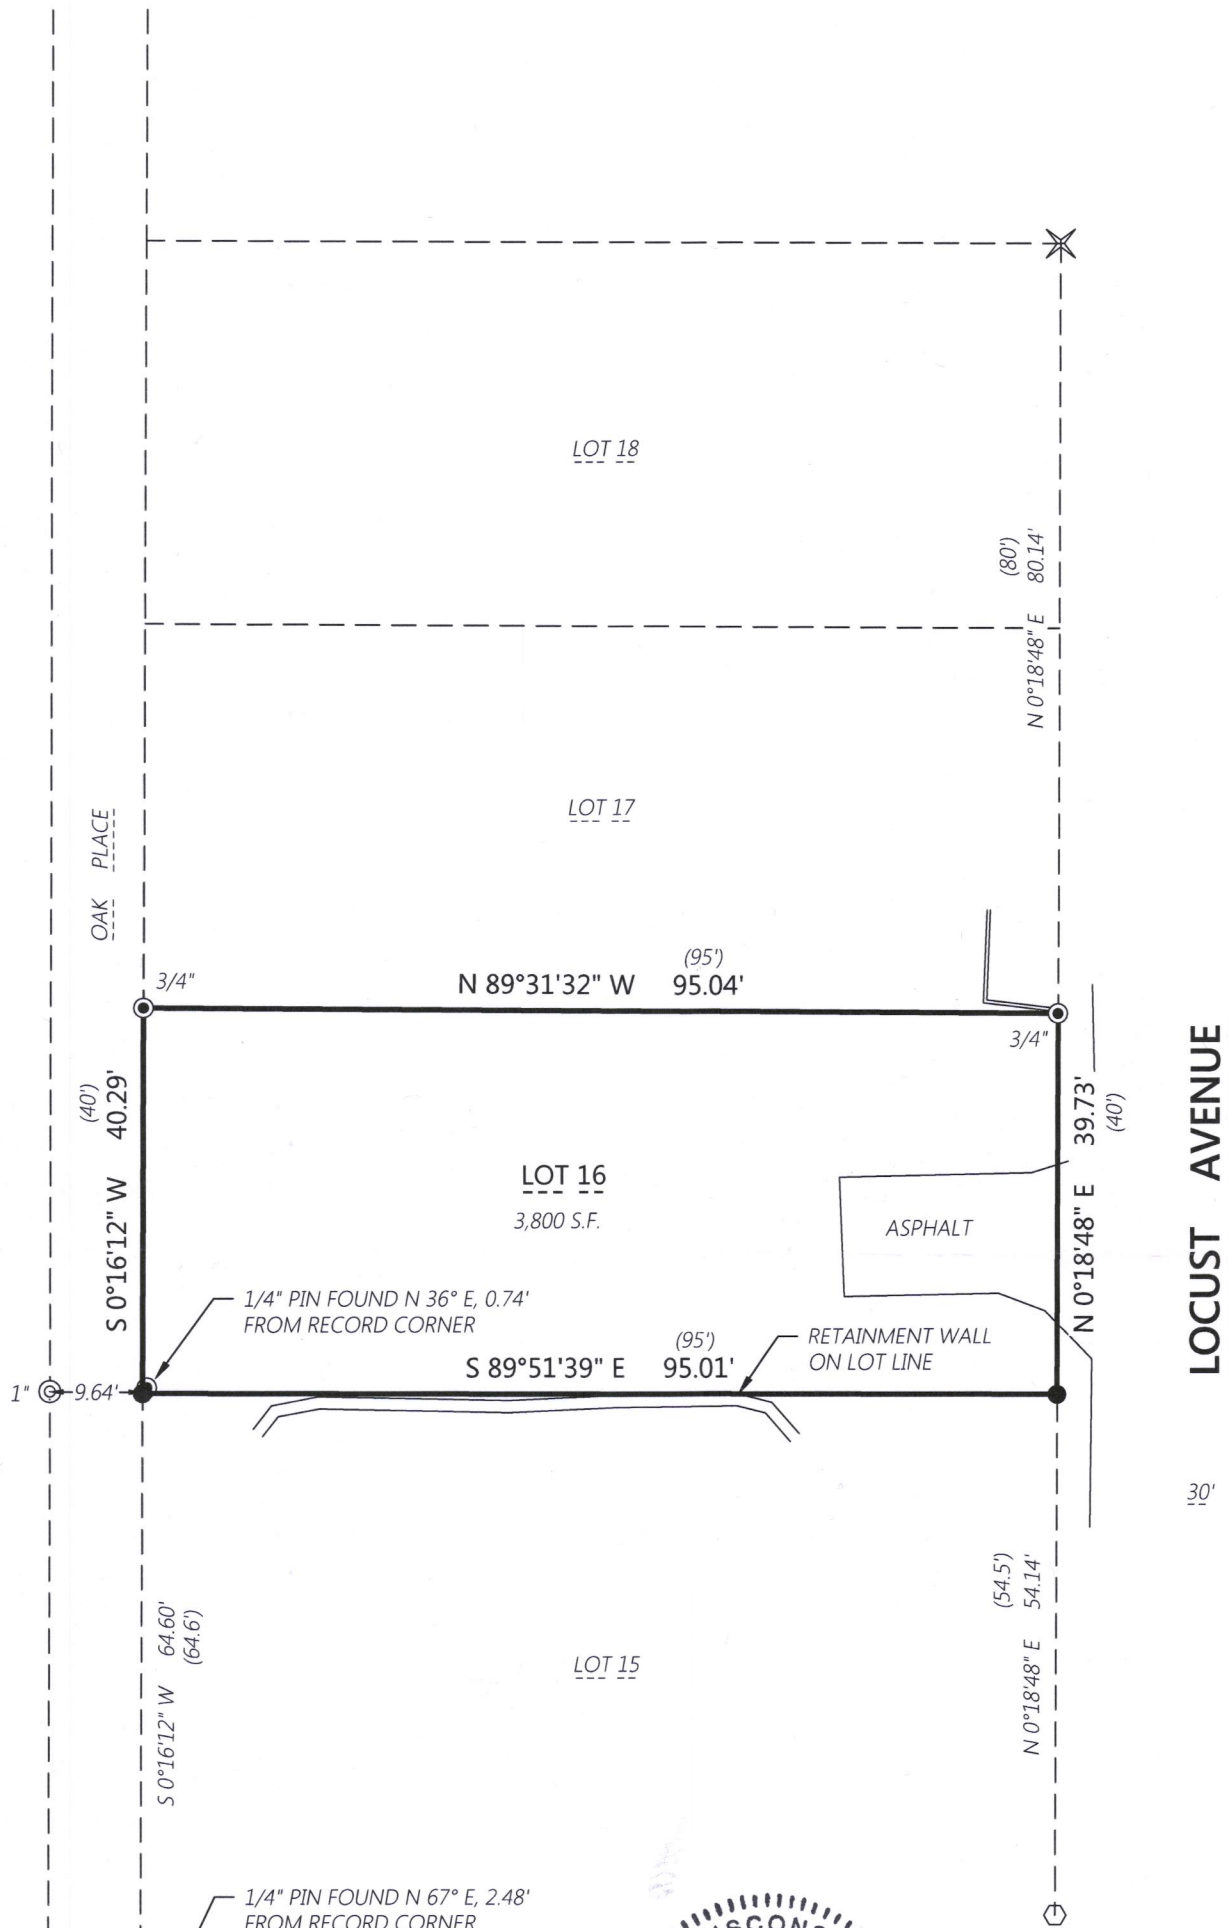

RECEIVED
APR 11 2018
By Jan



Kristin Belongia


Kristin J. Belongia, P.L.S.
Wisconsin Professional Land Surveyor S-2943

If the surveyor's signature is not red in color, the plan is a copy that should be assumed to contain unauthorized alterations. The certification contained on this document shall not apply to any copies.

State of Wisconsin } ss
County of Rock

I hereby certify that I have supervised the survey of the property described above and to the best my knowledge and belief, the plat drawn hereon correctly represents said survey and its location. Given under my hand and seal this 18th day of December, 2017 at Beloit, Wisconsin. Last day of field work December 15th, 2017.

- LEGEND**
- Iron Rebar Set 3/4" x 24" (1.5 Lbs./Ft.)
 - Iron Rebar Found
 - ⊙ Iron Pipe Found
 - ⊕ Concrete Monument Found
 - ✕ Chiseled Cross in Concrete
 - (XXX.XX) Record Information

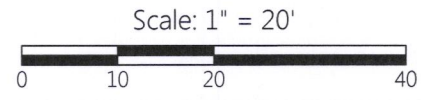

BEARINGS BASED ON THE EAST LINE OF OAK PLACE BEARING N 0°16'12" E



<p>ORDER NO: 32884 BOOK: 575/4 FIELD CREW: CB DRAWN BY: KJB DATE: December 18, 2017</p>	<p>FOR THE EXCLUSIVE USE OF: Michael Mandarino PO Box 1326 Elmhurst, IL 60126</p>	<p>PLAT OF SURVEY</p>	<p>Batterman engineers surveyors planners 2857 Bartells Drive Beloit, Wisconsin 53511 608.365.4464 www.rhbatterman.com</p> 
---	---	-----------------------	---

868-73 005-3395