
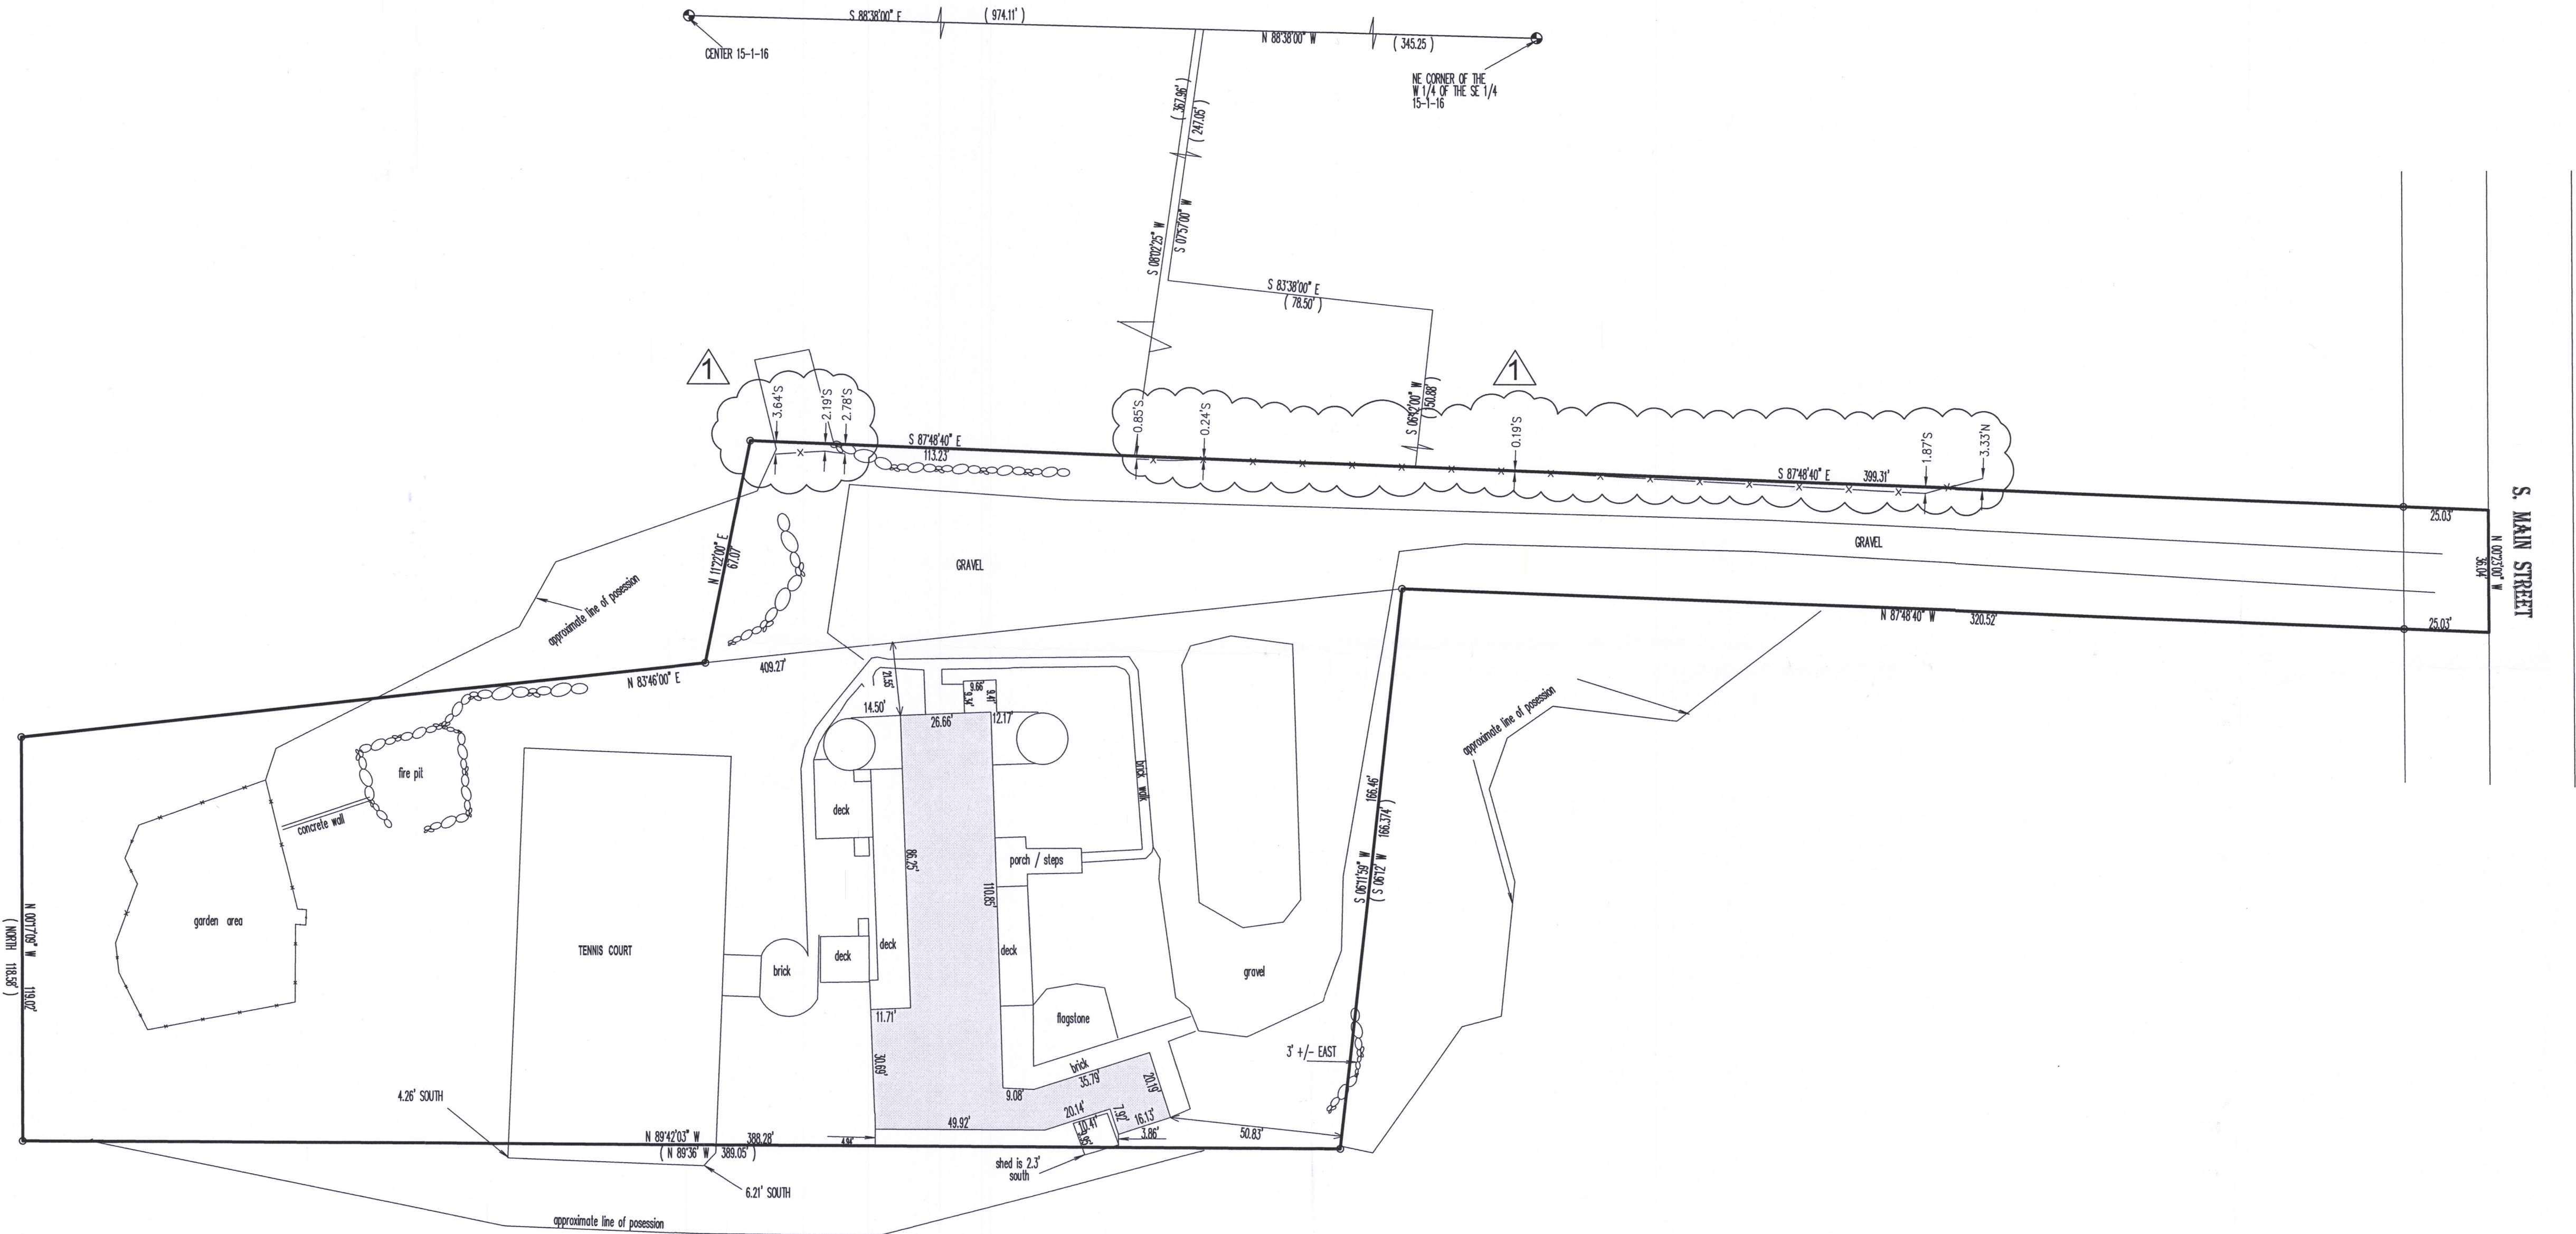


PLAT OF SURVEY


- OF -

PATHFINDER SURVEYING
(a NMB Company)
P.O. BOX 322
LAKE GENEVA, WI. 53147
WWW.PATHFINDERSURVEYING.NET
262-248-8303

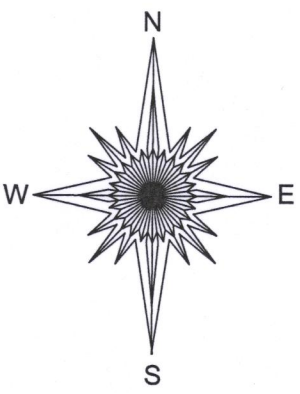

() = recorded as
○ = found iron pipe
● = set 5/8" rebar
—X— = fence

SCALE 1" = 30'
JOB # 2018.0094.01
TAX ID # STFV00040A

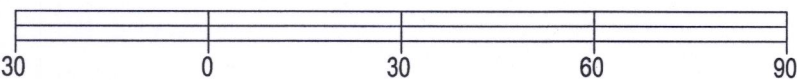

BASIS OF BEARING OF THIS PLAT: THE US STATE PLANE
COORDINATE SYSTEM SOUTH ZONE, NAD 83, WISCONSIN.


I hereby certify that I have surveyed the above-described property and the
above map is a true representation thereof and shows the size and
location of the property, its exterior boundaries, the location and dimensions
of all structures thereon, fences, apparent easements and roadways and
visible encroachments if any to the best of my knowledge and belief.

This survey is made for the present owners of the property, and those who
purchase, mortgage, or guarantee the title thereto, within one year from the
date hereof.

DATED THIS 12TH DAY OF APRIL, 2018.



THE TWO FENCES WERE LOCATED ON APRIL 11, 2018. ALL
OTHER ITEMS SHOWN ARE FROM THE PRIOR SURVEY DATED
FEBRUARY 2, 2017.

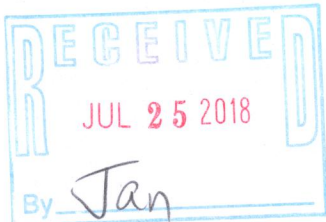

Mark R. Madsen
MARK R. MADSEN S-2271
Wisconsin Professional Land Surveyor