

LAND-MARK SURVEYING

Mark L. Miritz

Wisconsin Professional Land Surveyor S-2582

N9330 Knuteson Drive
Whitewater, WI 53190

Phone: (262) 495-3284

MARKMIRITZ@

LAND-MARKSURVEYING.COM



PLAT OF SURVEY

LEGAL DESCRIPTION

LOCATED IN THE SOUTHWEST 1/4 OF THE SOUTHWEST 1/4, SECTION 14,
TOWNSHIP 1 NORTH, RANGE 16 EAST, IN THE VILLAGE OF FONTANA-ON-
GENEVA, WALWORTH COUNTY, WISCONSIN

LOT H12, COUNTRY CLUB ESTATES ADDITION "H"

ORDERED BY:
ALLISON LIESKE
@ PROPERTIES
880 WEST MAIN STREET
LAKE GENEVA, WI 53147

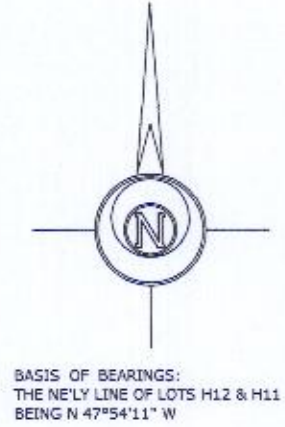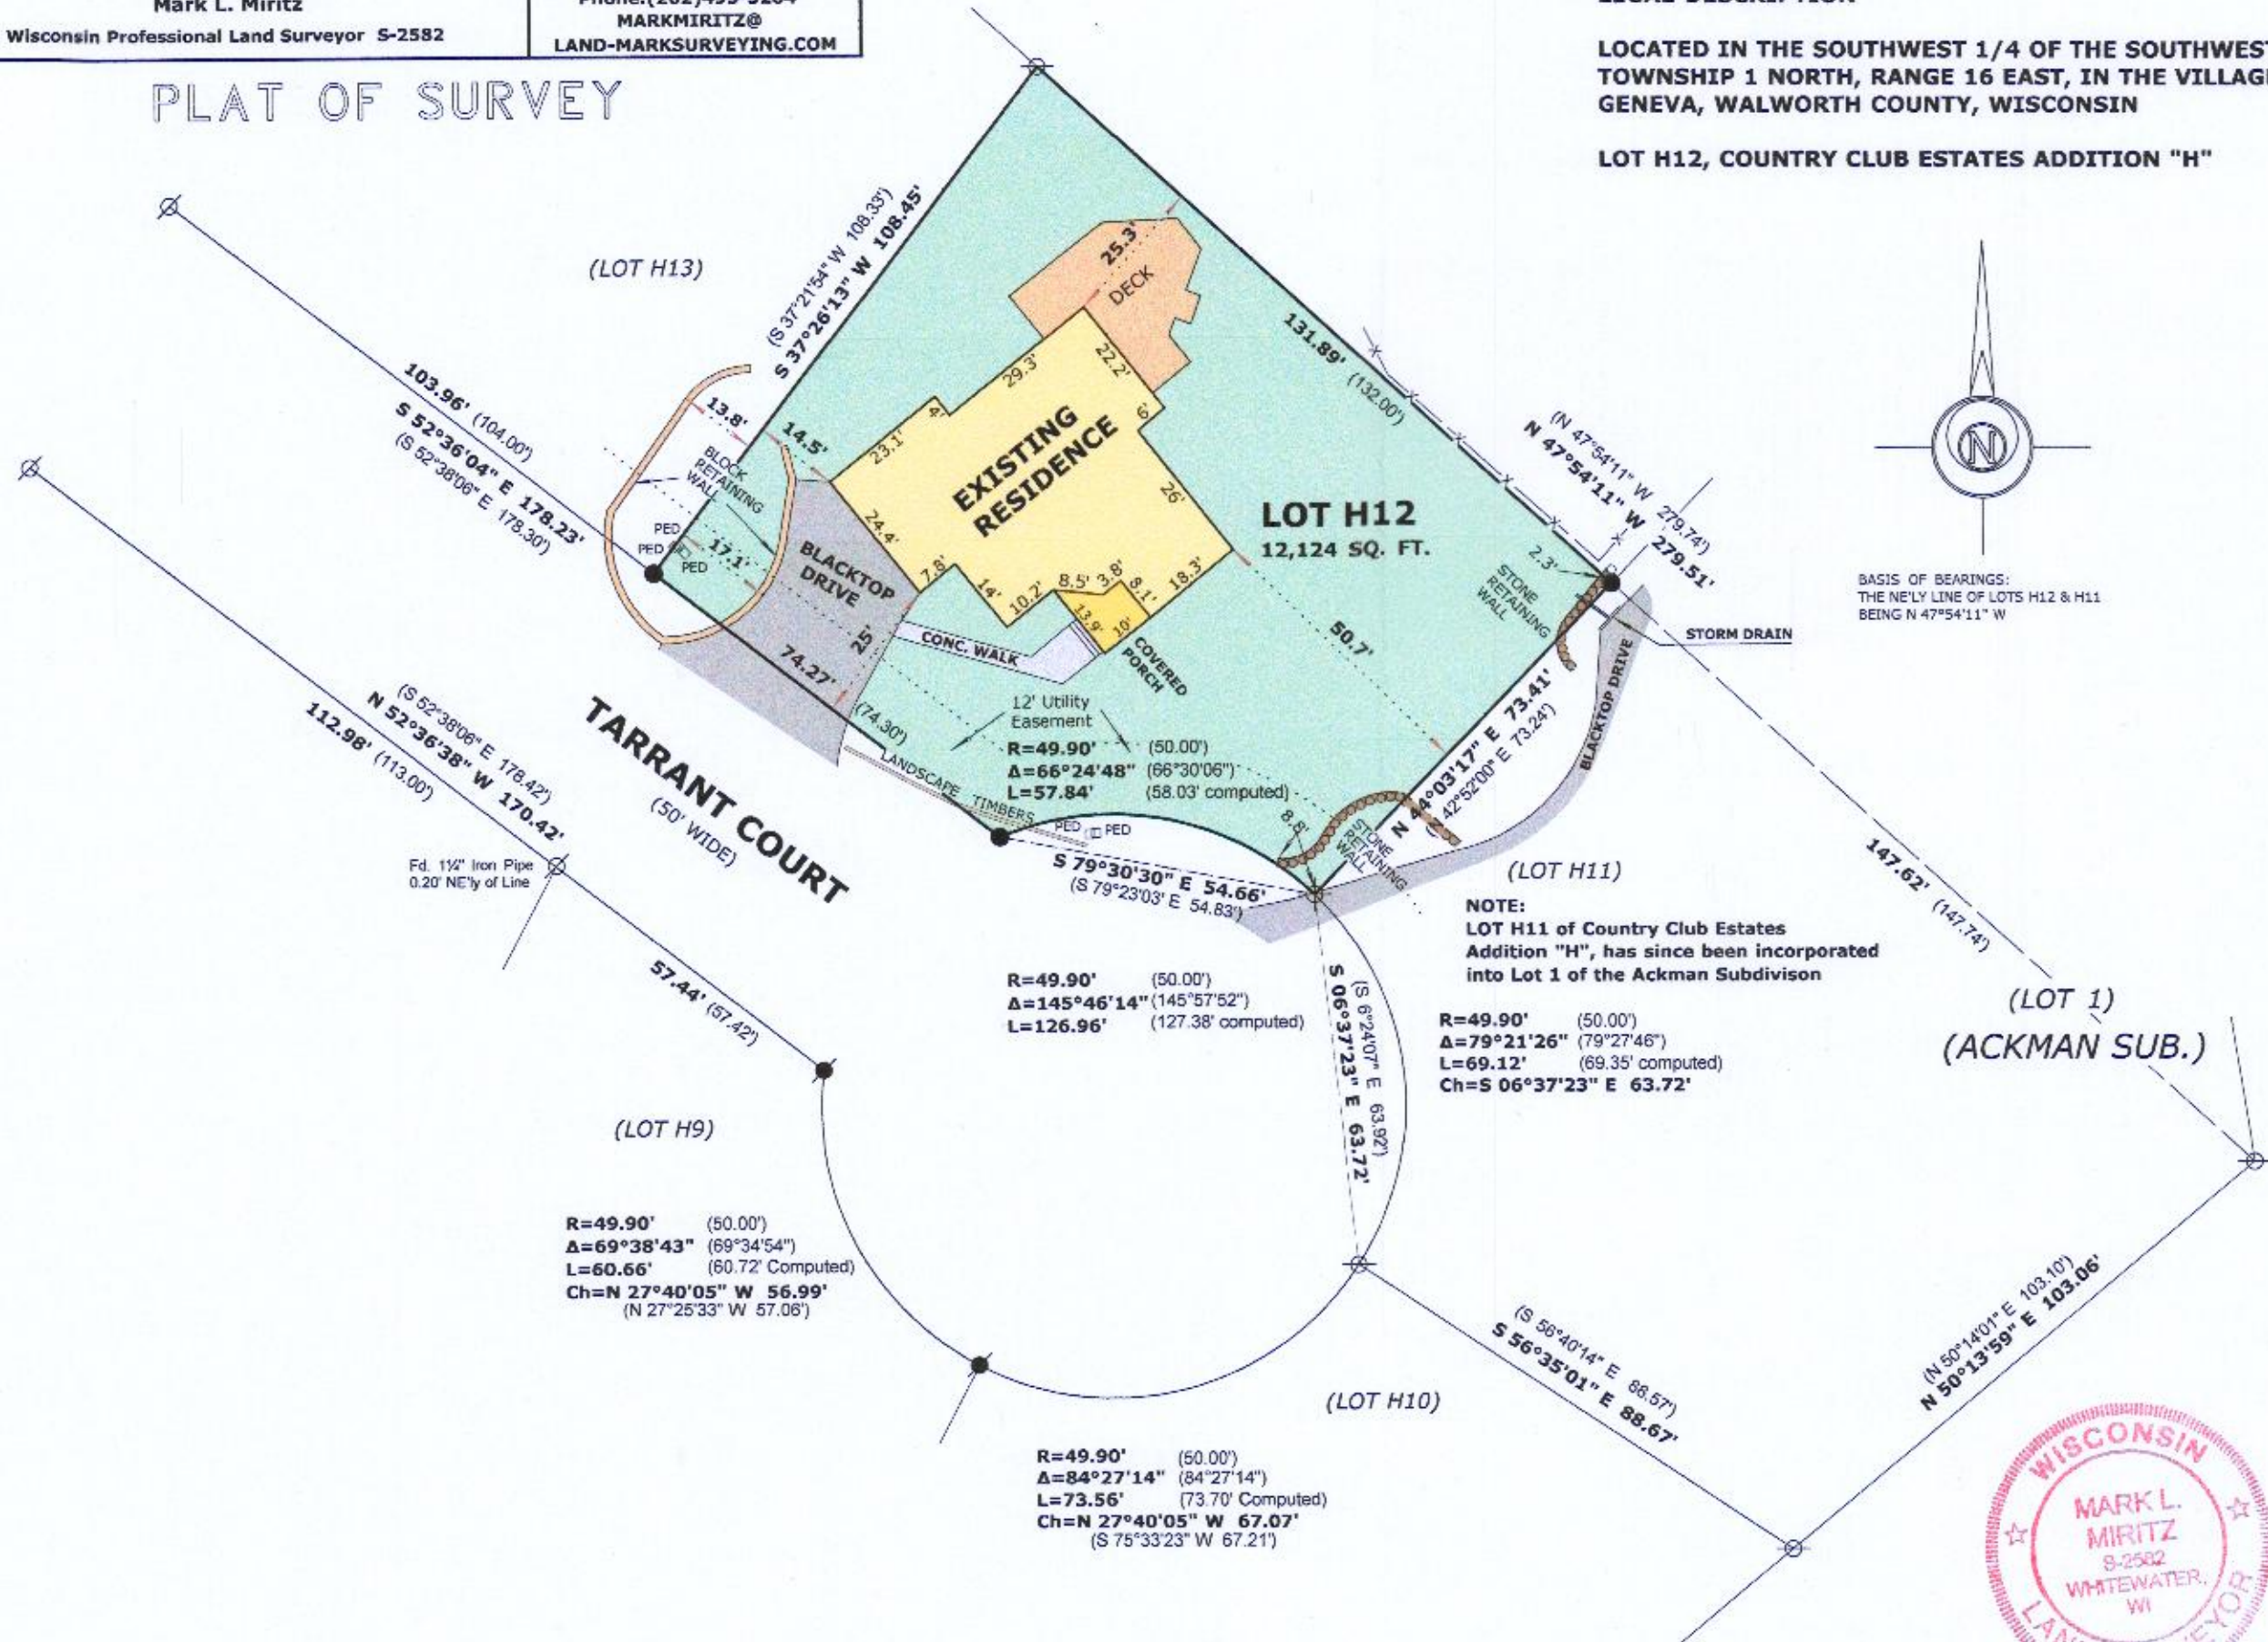

SC14-12 005-3481