


UNIT 167 OF ABBEY SPRINGS CONDOMINIUM NO. 5,
CREATED BY A "DECLARATION OF CONDOMINIUM"
RECORDED ON JULY 20, 1973 IN THE OFFICE OF THE
REGISTER OF DEEDS FOR WALWORTH COUNTY, WISCONSIN
IN VOLUME 97 OF RECORDS, PAGE 265, AS DOCUMENT
NO. 667480, TOGETHER WITH ANY AMENDMENTS AND/OR
CORRECTIONS THERETO, AND BY ITS CONDOMINIUM PLAT
AND ANY AMENDMENTS AND/OR CORRECTIONS THERETO.
SAID CONDOMINIUM BEING LOCATED IN THE VILLAGE OF
FONTANA-ON-GENEVA LAKE, COUNTY OF WALWORTH AND
STATE OF WISCONSIN.


UNIT 169

- FOUND 1-5/16" O.D. IRON PIPE
- ✎ FOUND RAILROAD SPIKE
- SET MASONRY NAIL
- () RECORDED AS


UNIT 168

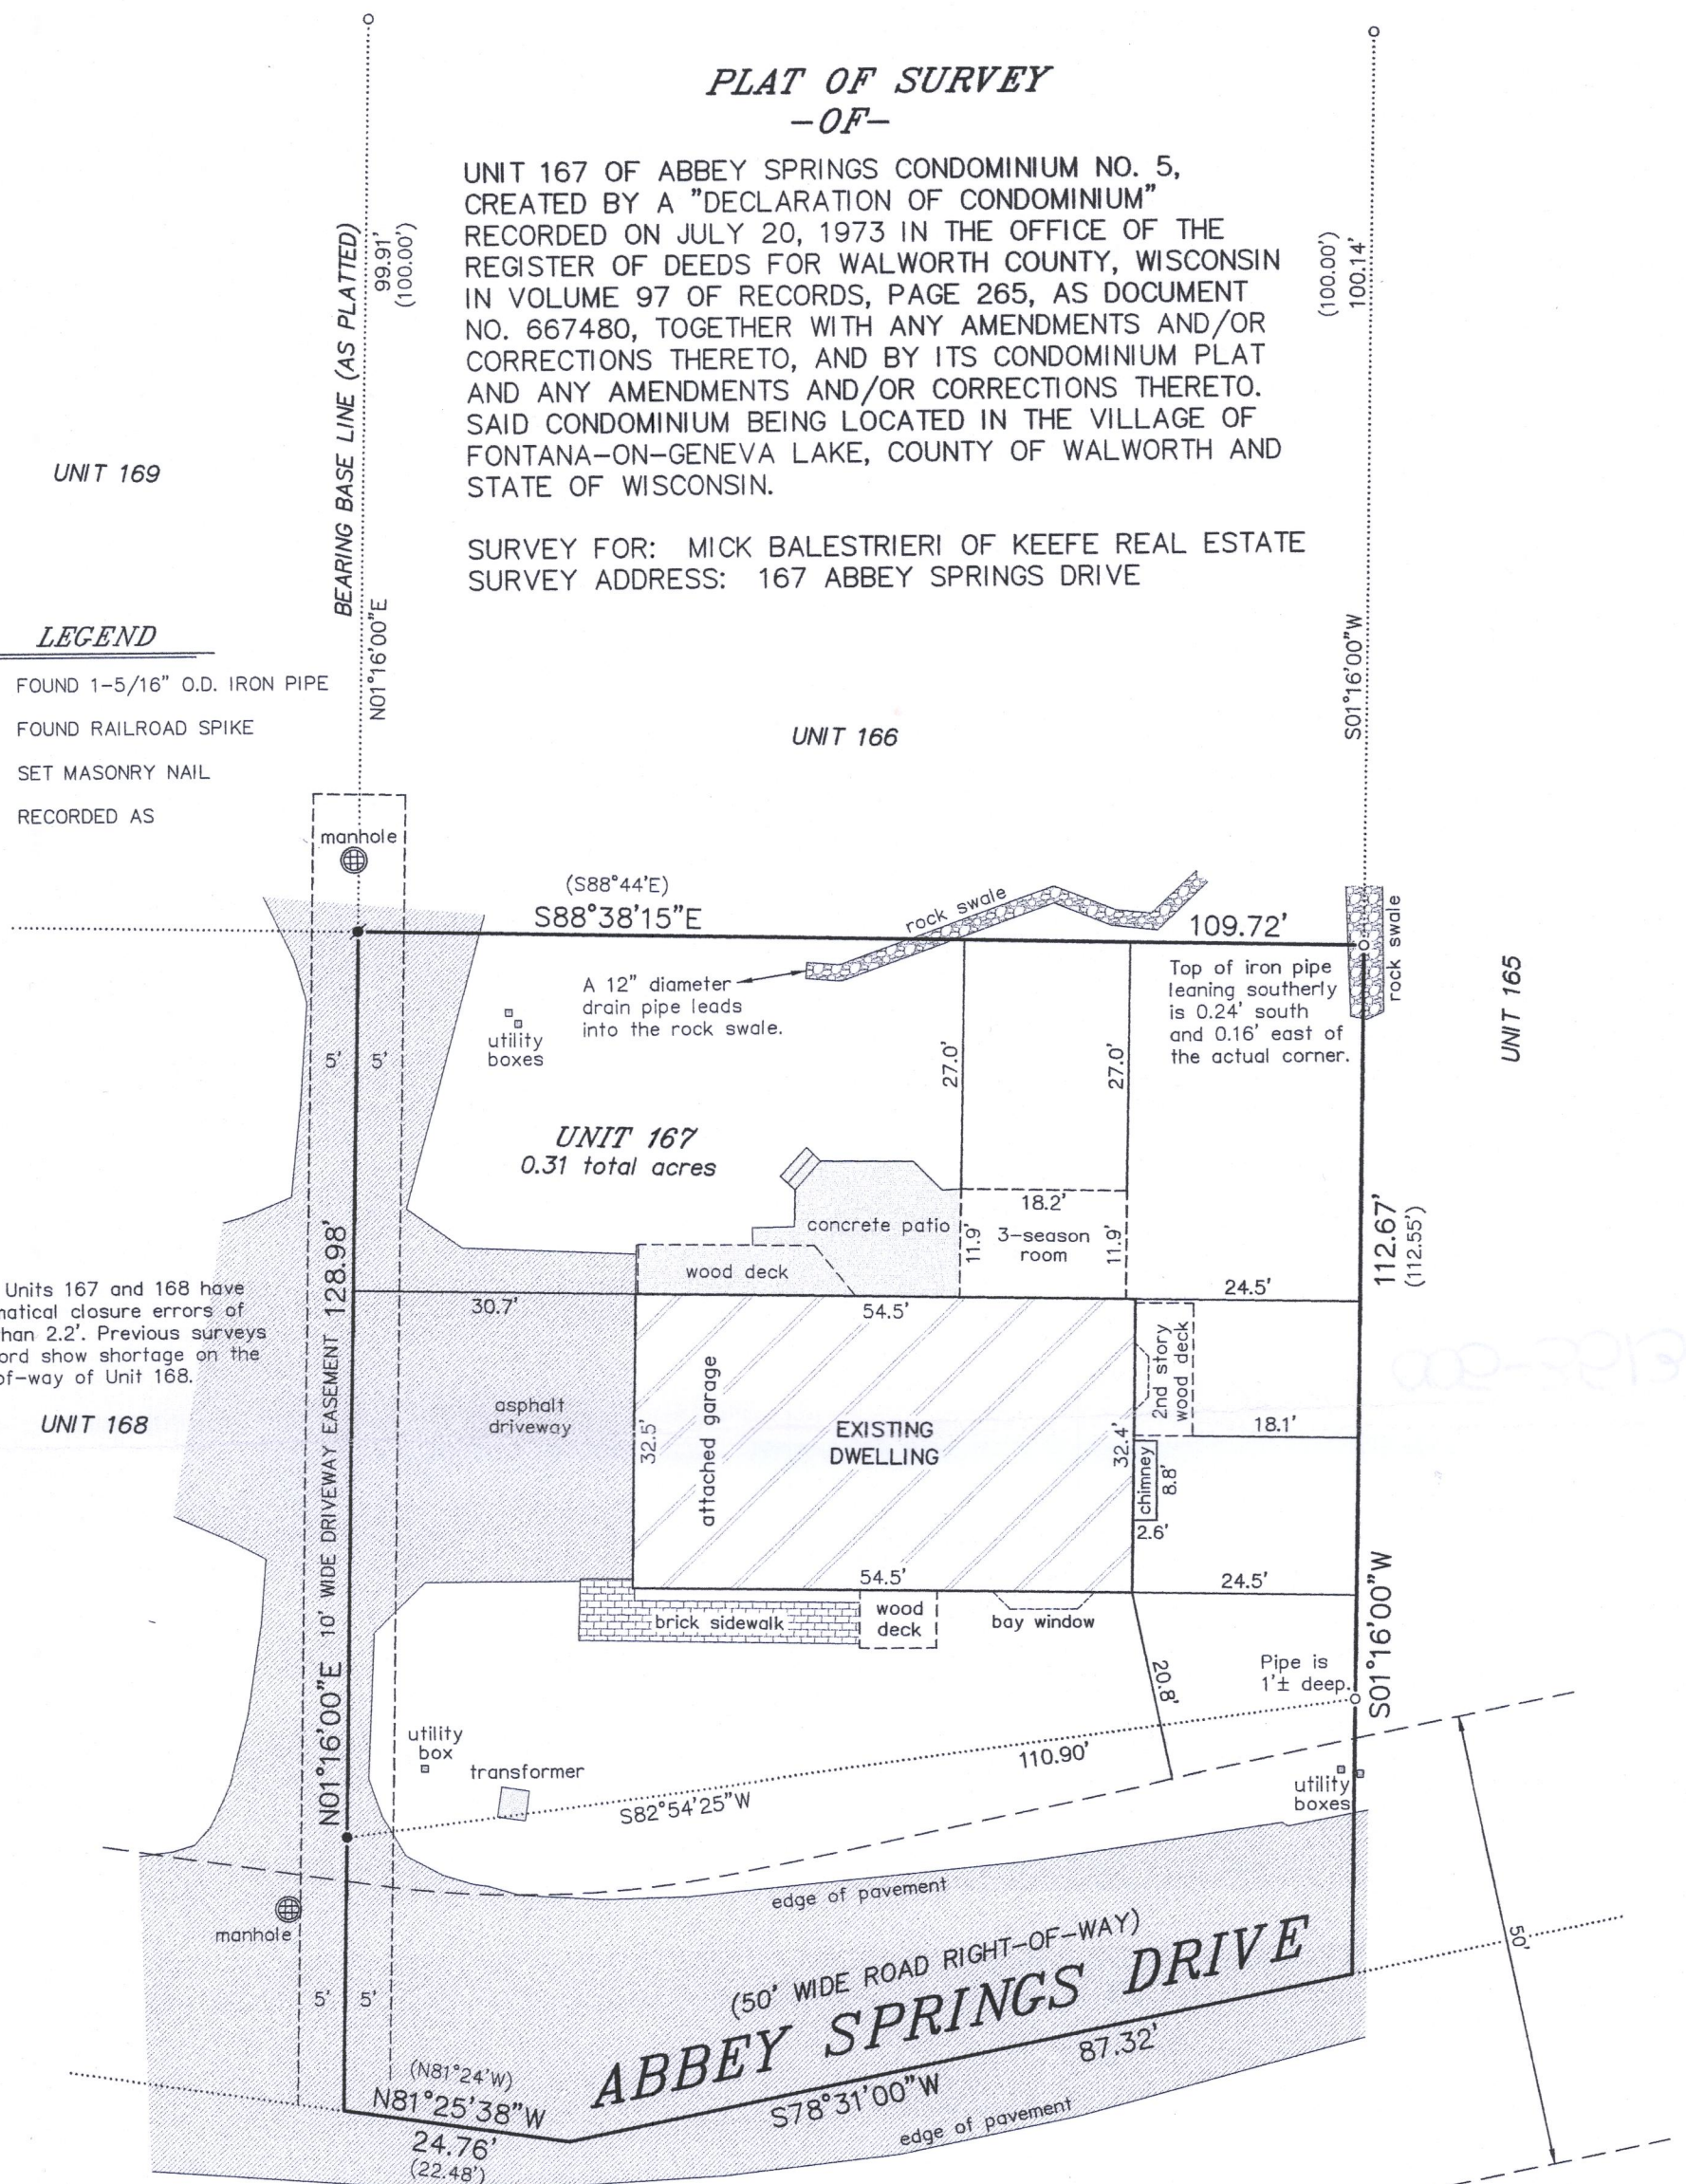

SATTER SURVEYING, LLC
LAND SURVEYS, MAPPING AND PLANNING
272 ORIGEN STREET
BURLINGTON, WI 53105
262-661-4239

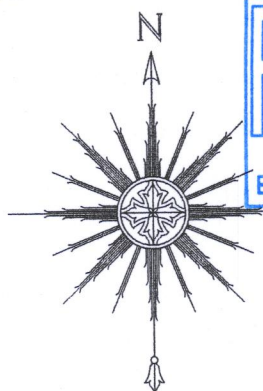

RECEIVED
FEB 3 2020
By SMF

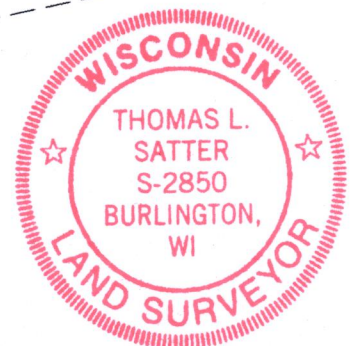

Thomas L. Satter

121902
JOB NUMBER

SCDB 5-167

005-3513