



LOCATION: 266 Fair Oaks Drive, Fontana, Wisconsin

PREPARED FOR: Alec Gizzi

LEGAL DESCRIPTION:  
Lot 24 of Buena Vista Subdivision, Located in the Village of  
Fontana-On-Geneva Lake, Walworth County, Wisconsin.

CURRENT OWNER: Alec A. & Karen D., Alessandro A.  
Gizzi Trust

TAX ID: SBV 00017

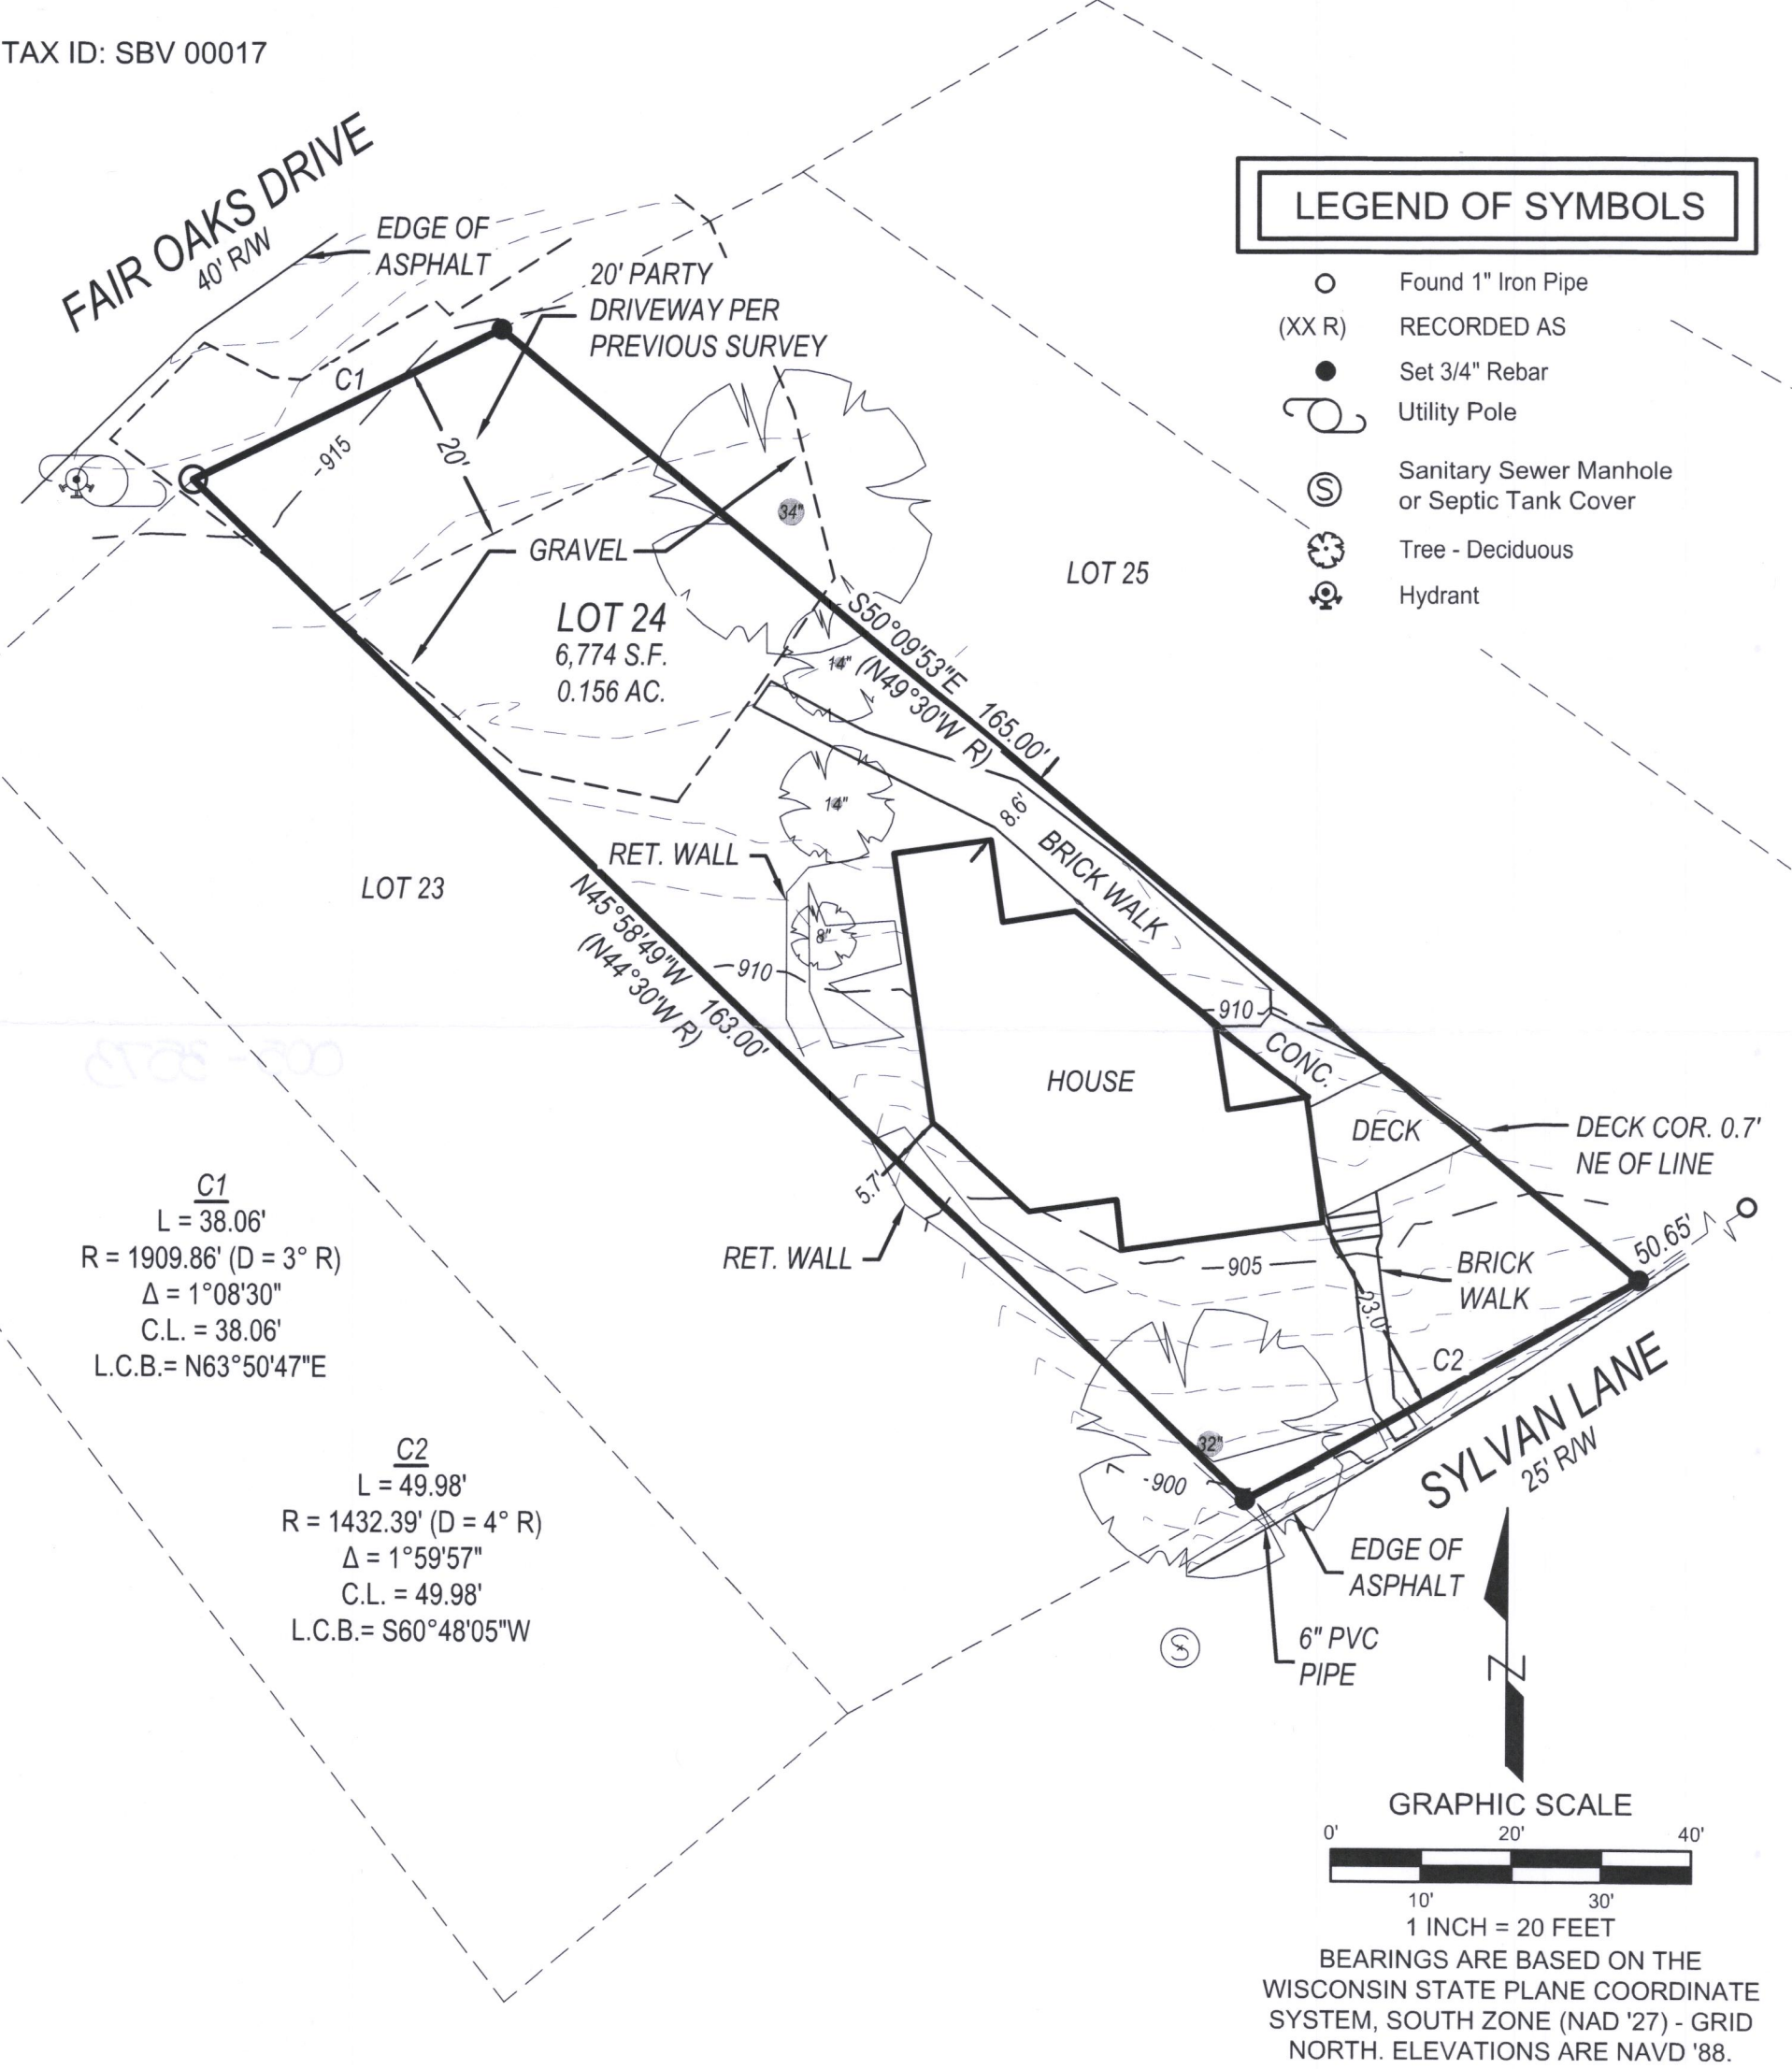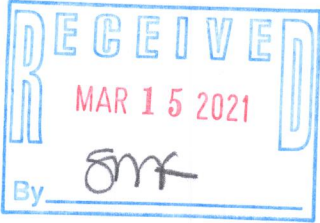

**LYNCH & ASSOCIATES**  
ENGINEERING CONSULTANTS, LLC  
5482 S. WESTRIDGE DRIVE  
NEW BERLIN, WI 53151  
440 MILWAUKEE AVENUE  
BURLINGTON, WI 53185  
(262) 402-5040

WISCONSIN  
PETER J. NIELSON  
S-2527  
MILWAUKEE, WI  
LAND SURVEYOR

I have surveyed the above-described property and the above map is a true representation thereof and shows the size and location of the property, its exterior boundaries, the location and dimensions of all structures thereon, fences, apparent easements and roadways, and visible encroachments, if any.

No title commitment or results of a title search were provided to this office pertaining to this survey. This Plat Of Survey may not reflect easements of record, encumbrances, restrictions, ownership, title evidence, or other facts that a current and accurate title search may disclose.

This survey is made for the exclusive use of the present owners of the property, and also those who purchase, mortgage, or insure the title thereto within one (1) year from date hereof; and as to them I warrant the accuracy of said survey map.

*Peter J. Nielson*  
PETER J. NIELSON, PROFESSIONAL LAND SURVEYOR, S-2527

SBV-17

005-3573