

LAND-MARK SURVEYING
Mark L. Miritz

Wisconsin Registered Land Surveyor S-2582



N9330 Knuteson Drive
Whitewater, WI 53190
Phone: (262) 495-3284
MARKMIRITZ@
LAND-MARKSURVEYING.COM

PLAT OF SURVEY

NORTH 1/2 OF LOT 19 AND ALL OF LOTS 20 AND 21 IN BLOCK 15 OF GLENWOOD SPRINGS, LOCATED IN THE SOUTHEAST 1/4 OF SECTION 14, TOWN 1 NORTH, RANGE 16 EAST, VILLAGE OF FONTANA-ON-GENEVA LAKE, WALWORTH COUNTY, WISCONSIN.

OWNER:
LAURA I TAYLOR
647 LINDEN AVE.
FONTANA, WI 53125

THE EAST LINE OF LOTS 19-21 WAS ASSUMED TO BEAR NORTH

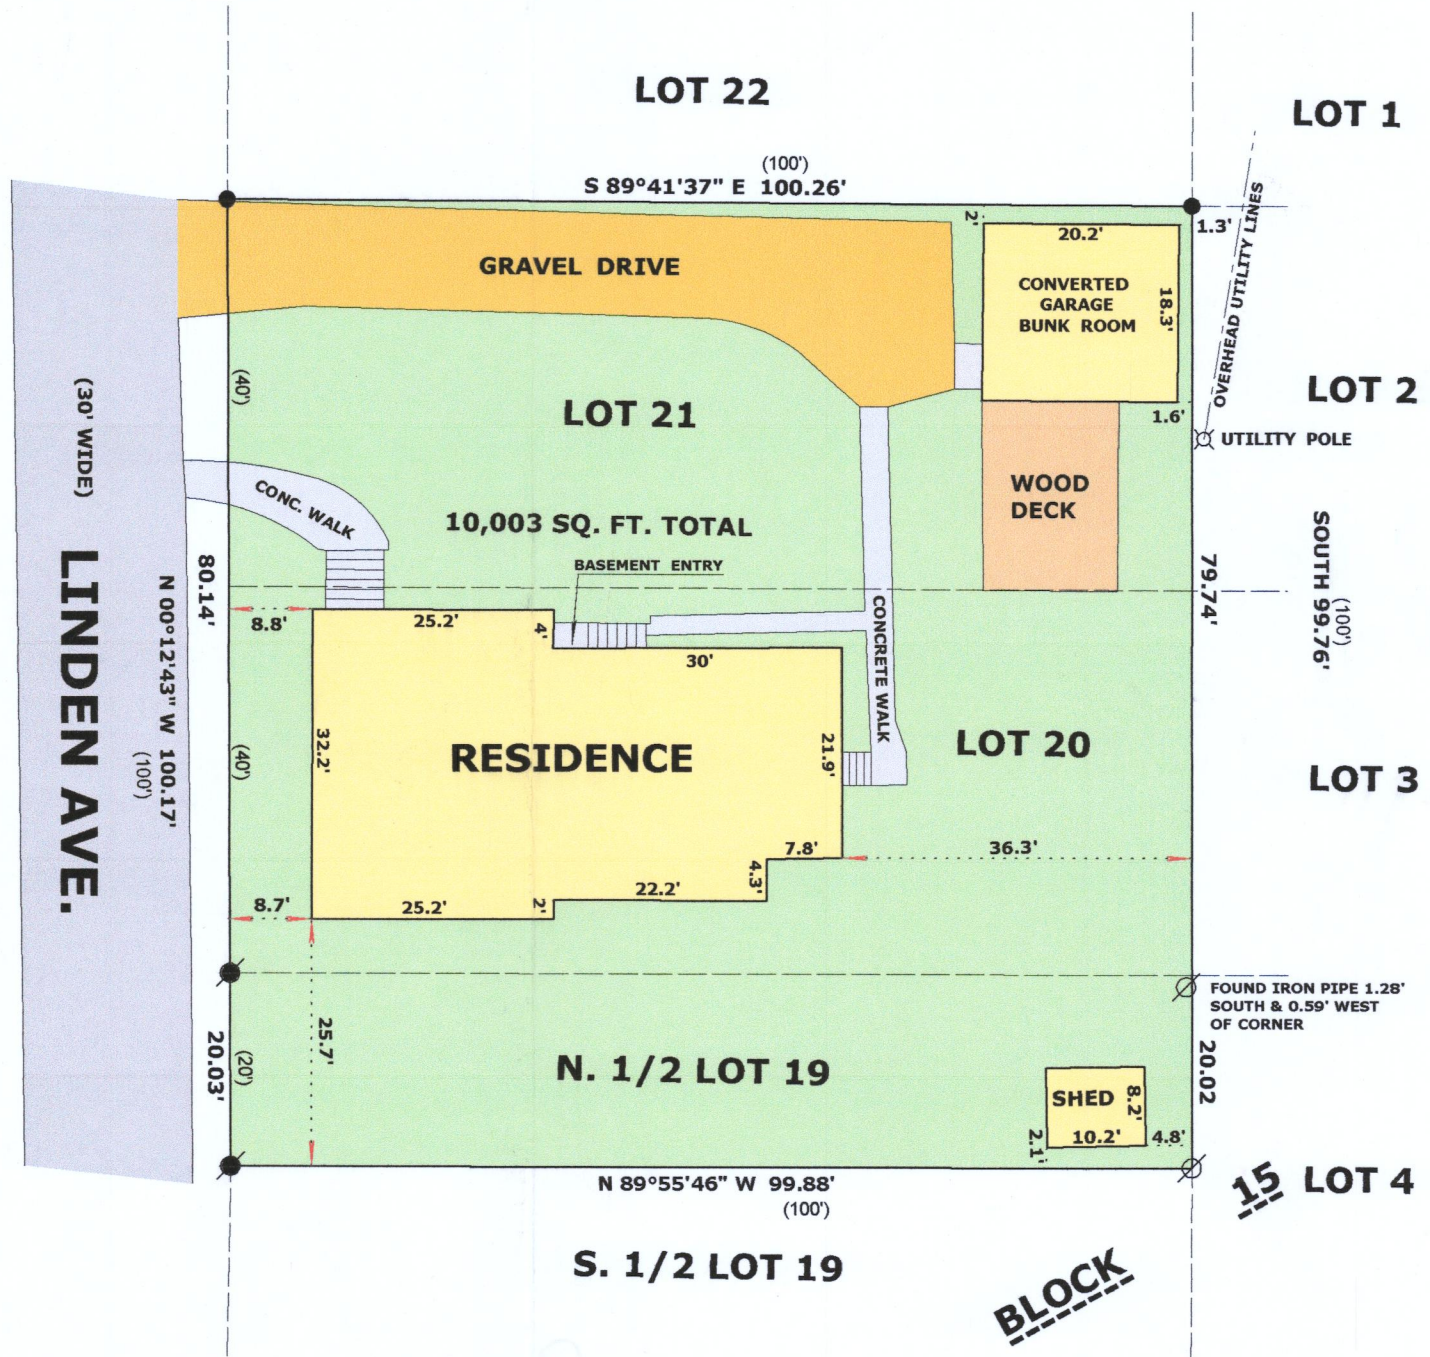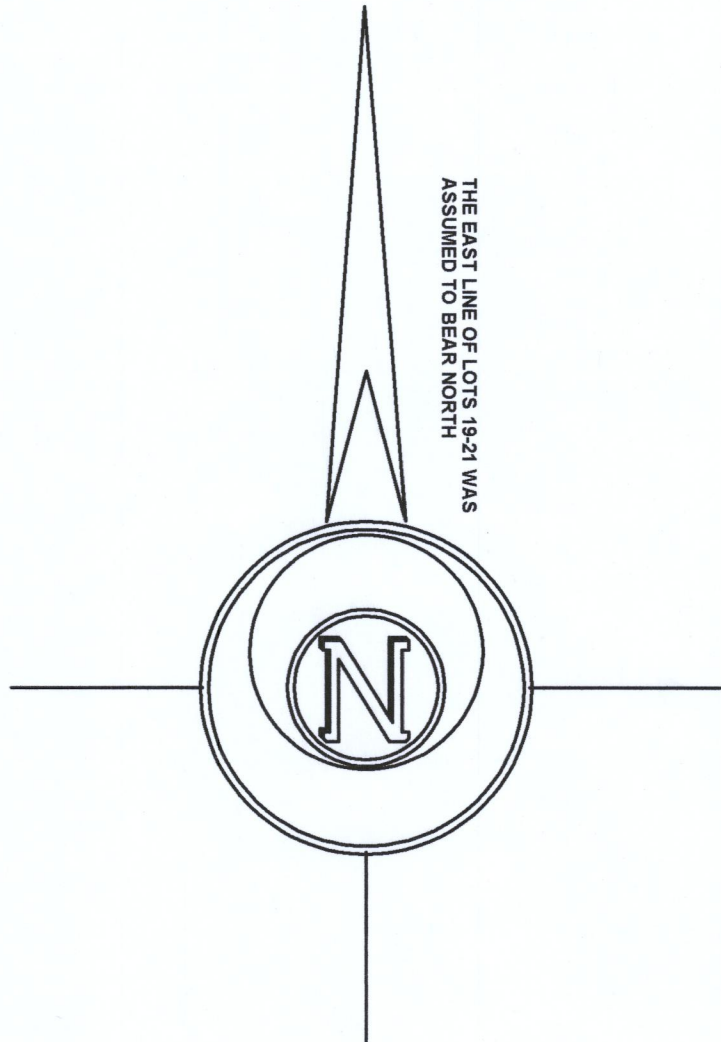

RECEIVED
MAY 24 2021
By *SMF*



LEGEND

- FOUND IRON PIPE 1 1/4"
- FOUND IRON PIPE 1"
- FOUND PINCH PIPE
- RECORDED AS DIMENSION
- EXISTING WIRE FENCE

SCALE: 1 INCH = 20 FEET

"I hereby certify that the above described property has been surveyed by me or under my direction and that the above map is a true representation thereof and shows the size and location of the property, its exterior boundaries, the location of all visible structures and dimensions of all principal buildings thereon, boundary fences, apparent easements, roadways and visible encroachments, if any."
"This survey is made for the use of the present owners of the property, and also those who purchase, mortgage, or guarantee the title thereto within one year from date hereof."

Mark L. Miritz
MARK L. MIRITZ
WISCONSIN REGISTERED
LAND SURVEYOR S-2582

REVISED MAY 15, 2021 DATE: JULY 27, 2014 JOB NO. 14.710

563-110

005-3621