
LAKELAND SURVEYORS LLC 236 STH 50 SUITE B DELAVAN, WI 53115 262-475-9567

PLAT OF SURVEY

PREPARED FOR: VITO CRISTINO LINDA CRISTINO

LOT F26, ADDITION "F" OF COUNTRY CLUB ESTATES, LOCATED IN THE VILLAGE OF FONTANA-ON-GENEVA-LAKE, WALWORTH COUNTY, WISCONSIN.

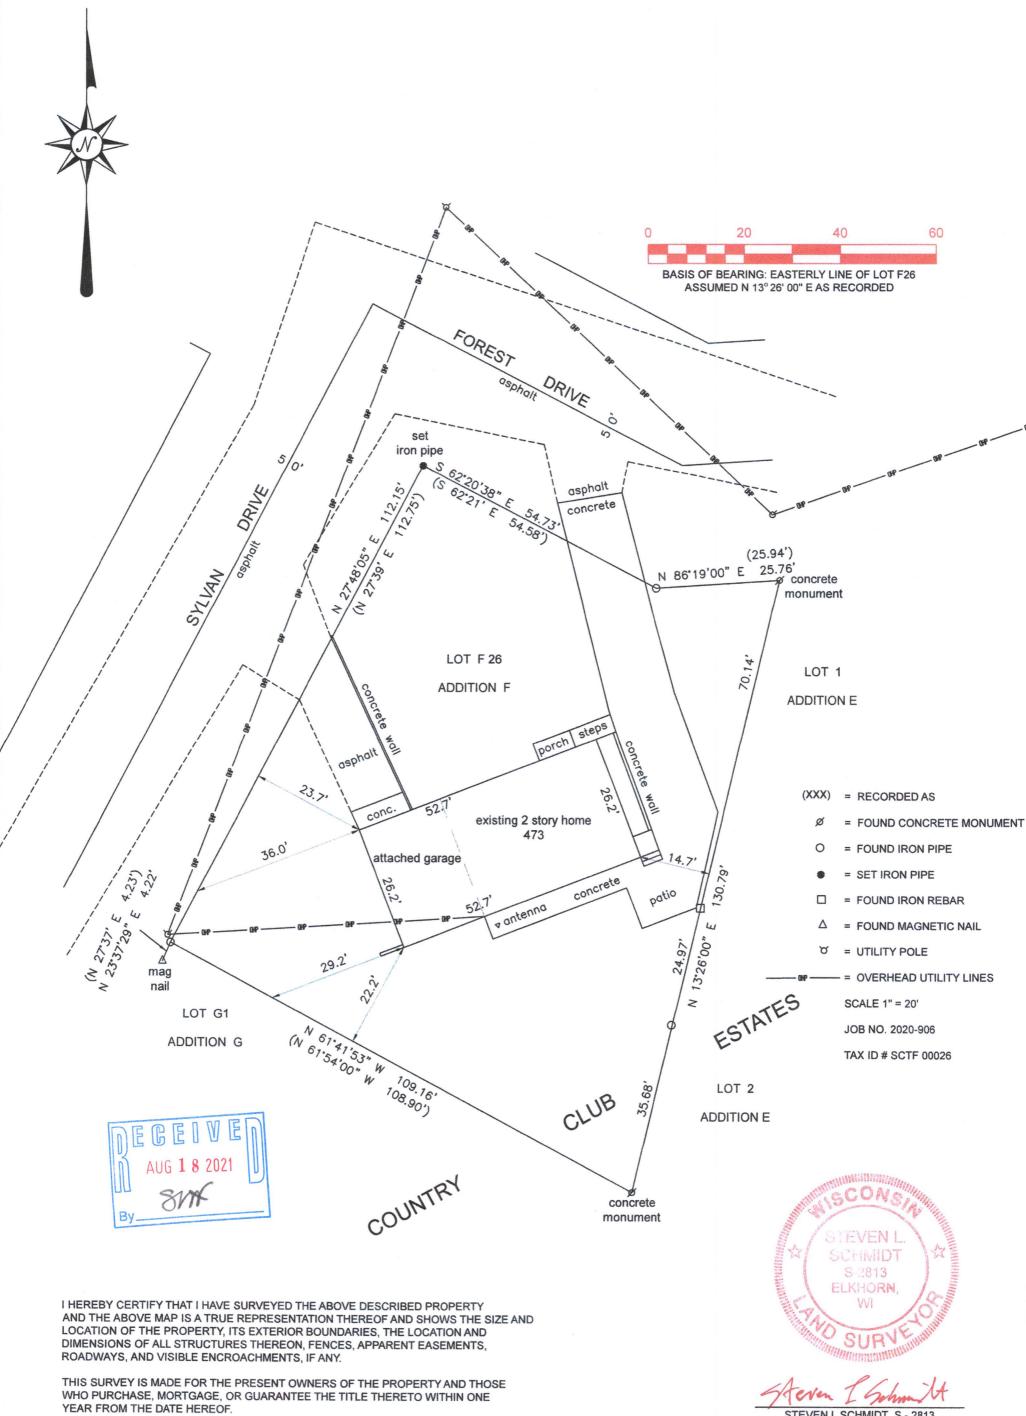

DATED THIS 6TH DAY OF JANUARY 2021

STEVEN L SCHMIDT S - 2813 Wisconsin Professional Land Surveyor