


PLAT OF SURVEY
-OF-

LOTS 14 AND 15, EXCEPT 5 FEET OFF THE EAST END OF SAID LOTS, IN BLOCK 1 OF GLENWOOD SPRINGS SUBDIVISION, ACCORDING TO THE RECORDED PLAT THEREOF. SAID LAND BEING IN THE VILLAGE OF FONTANA-ON-GENEVA LAKE, COUNTY OF WALWORTH AND STATE OF WISCONSIN.

SURVEY FOR: ED & CHERYL MALONEY
SURVEY ADDRESS: 673 MAPLE DRIVE, FONTANA, WI 53125

NOTE: REFER TO A CURRENT TITLE REPORT FOR EASEMENTS, RESTRICTIONS OR COVENANTS WHICH MAY AFFECT THIS PROPERTY.

- LEGEND**
- FOUND IRON PIPE
 - FOUND IRON ROD
 - () RECORDED AS

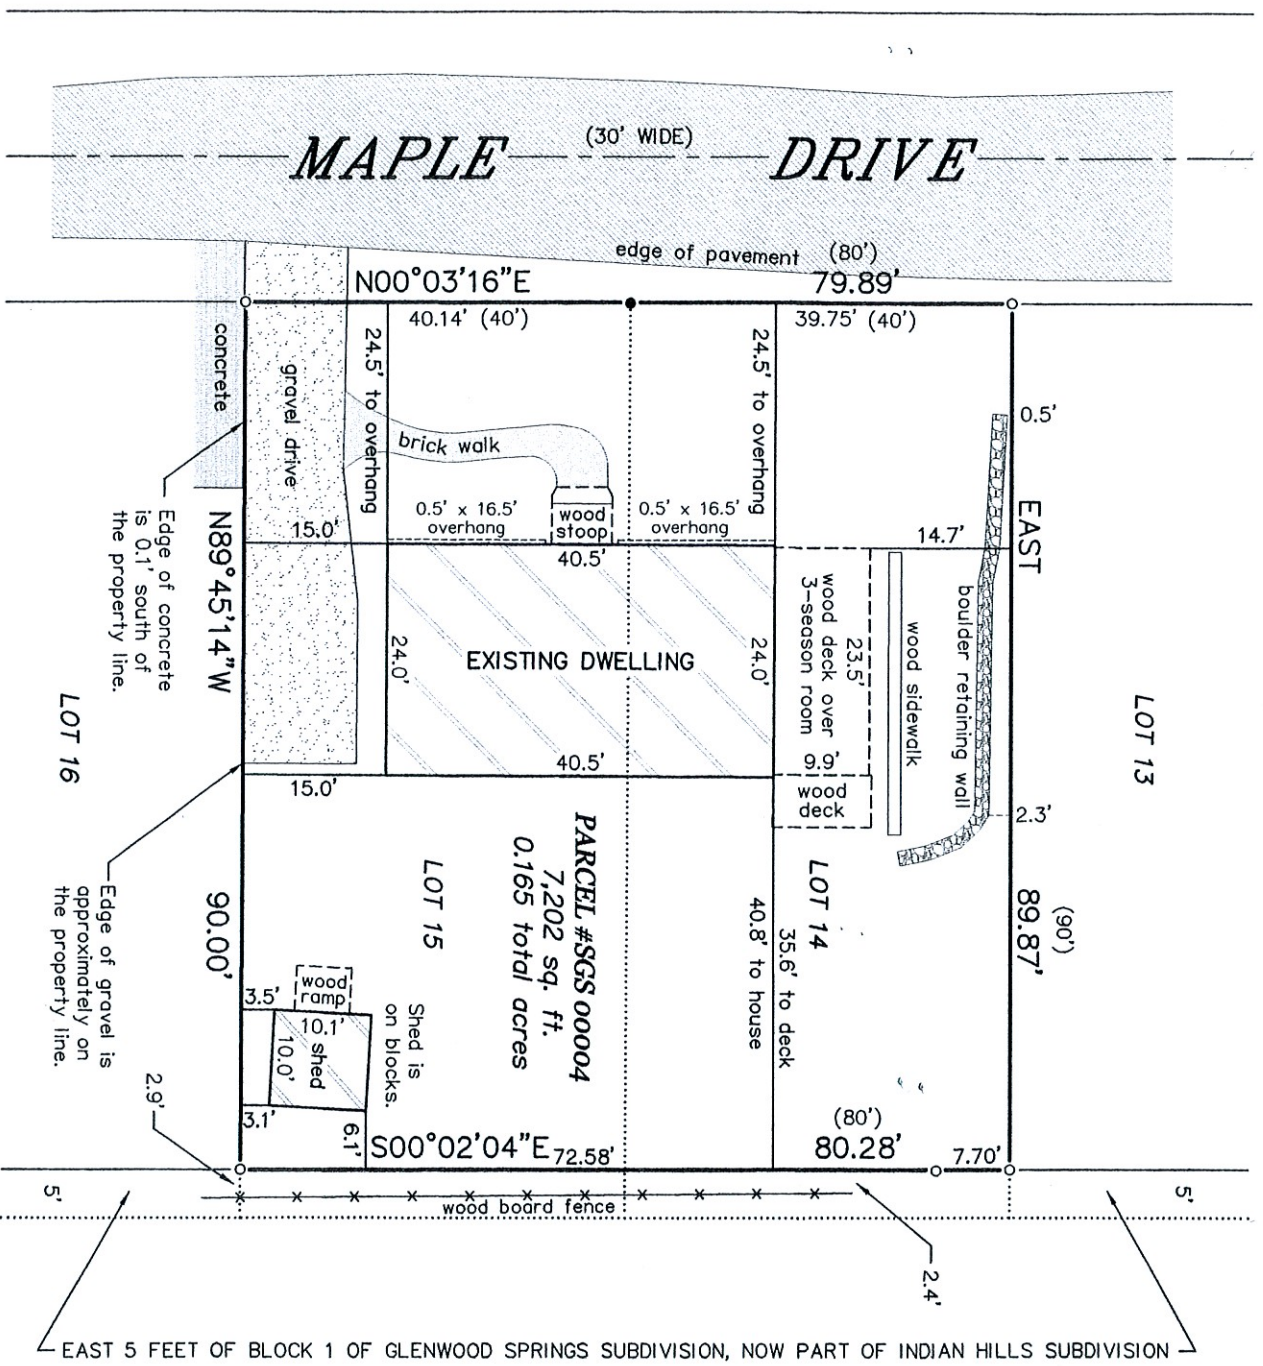

BEARINGS HEREON RELATE TO THE NORTH LINE OF LOT 14 OF GLENWOOD SPRINGS SUBDIVISION. ASSUMED BEARING OF EAST.

"I HEREBY CERTIFY THAT I HAVE SURVEYED THE ABOVE DESCRIBED PROPERTY AND THAT THE ABOVE MAP IS A CORRECT REPRESENTATION THEREOF AND SHOWS THE SIZE AND LOCATION OF THE PROPERTY, ITS EXTERIOR BOUNDARIES, BOUNDARY FENCES, APPARENT EASEMENTS, ROADWAYS AND ENCROACHMENTS, IF ANY."



"THIS SURVEY IS MADE FOR THE USE OF THE PRESENT OWNERS OF THE PROPERTY, AND THOSE WHO PURCHASE, MORTGAGE, OR GUARANTEE THE TITLE THERETO WITHIN ONE YEAR FROM DATE HEREOF."

THIS IS NOT AN ORIGINAL PRINT UNLESS THIS SEAL IS RED.



Thomas L. Satter
THOMAS L. SATTER S-2850
BURLINGTON, WI

SATTER SURVEYING, LLC
LAND SURVEYS, MAPPING AND PLANNING
272 ORIGEN STREET
BURLINGTON, WI 53105
262-661-4239

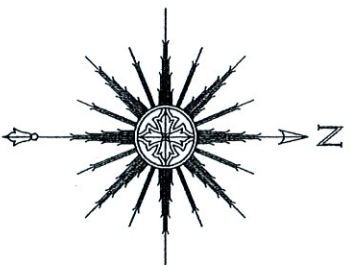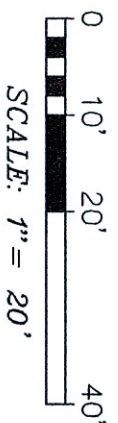

REVISSED: 3/8/22
JUNE 29, 2015
DATE

061511
JOB NUMBER