
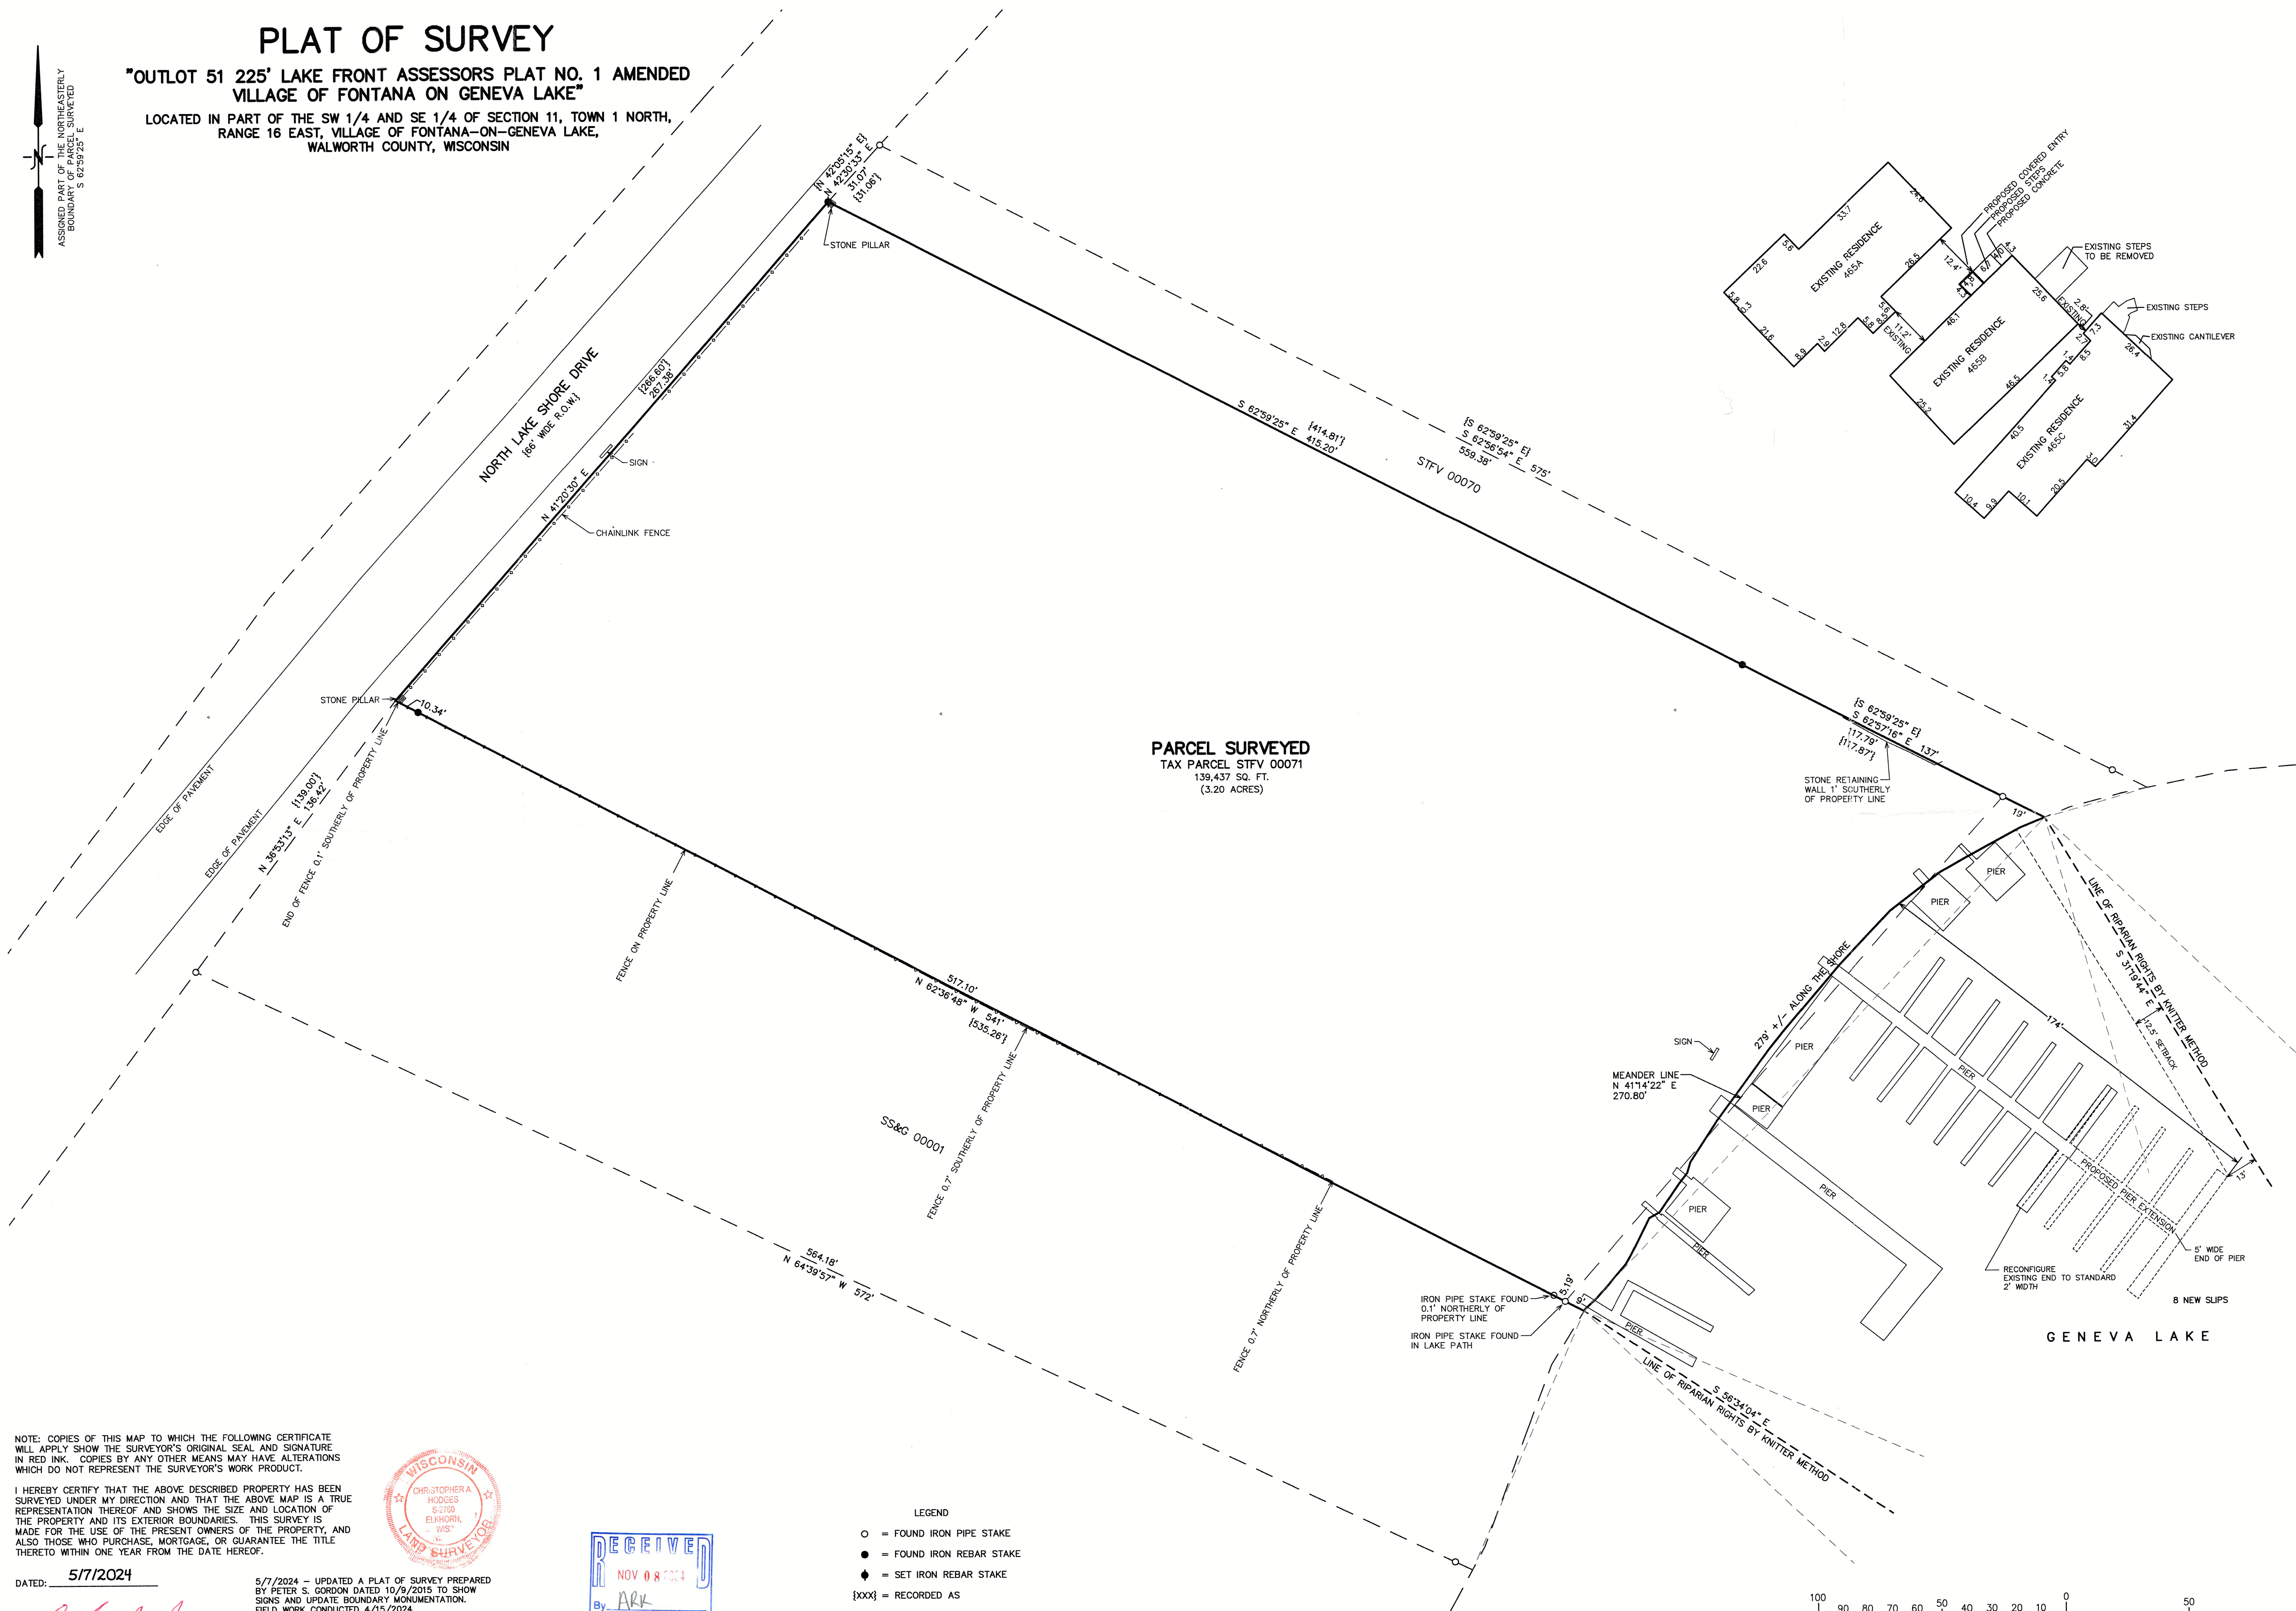


PLAT OF SURVEY

"OUTLOT 51 225' LAKE FRONT ASSESSORS PLAT NO. 1 AMENDED
VILLAGE OF FONTANA ON GENEVA LAKE"

LOCATED IN PART OF THE SW 1/4 AND SE 1/4 OF SECTION 11, TOWN 1 NORTH,
RANGE 16 EAST, VILLAGE OF FONTANA-ON-GENEVA LAKE,
WALWORTH COUNTY, WISCONSIN

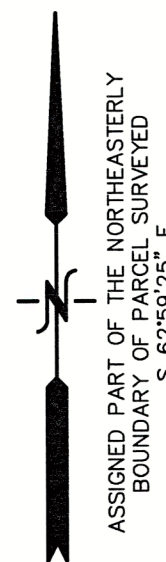

PARCEL SURVEYED
TAX PARCEL STFV 00071
139,437 SQ. FT.
(3.20 ACRES)



- LEGEND
- = FOUND IRON PIPE STAKE
 - = FOUND IRON REBAR STAKE
 - ◆ = SET IRON REBAR STAKE
 - {xxx} = RECORDED AS

NOTE: COPIES OF THIS MAP TO WHICH THE FOLLOWING CERTIFICATE
WILL APPLY SHOW THE SURVEYOR'S ORIGINAL SEAL AND SIGNATURE
IN RED INK. COPIES BY ANY OTHER MEANS MAY HAVE ALTERATIONS
WHICH DO NOT REPRESENT THE SURVEYOR'S WORK PRODUCT.


I HEREBY CERTIFY THAT THE ABOVE DESCRIBED PROPERTY HAS BEEN
SURVEYED UNDER MY DIRECTION AND THAT THE ABOVE MAP IS A TRUE
REPRESENTATION THEREOF AND SHOWS THE SIZE AND LOCATION OF
THE PROPERTY AND ITS EXTERIOR BOUNDARIES. THIS SURVEY IS
MADE FOR THE USE OF THE PRESENT OWNERS OF THE PROPERTY, AND
ALSO THOSE WHO PURCHASE, MORTGAGE, OR GUARANTEE THE TITLE
THERE TO WITHIN ONE YEAR FROM THE DATE HEREOF.

DATED: 5/7/2024

5/7/2024 - UPDATED A PLAT OF SURVEY PREPARED
BY PETER S. GORDON DATED 10/9/2015 TO SHOW
SIGNS AND UPDATE BOUNDARY MONUMENTATION.
FIELD WORK CONDUCTED 4/15/2024.

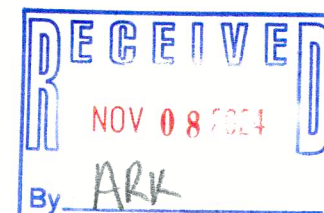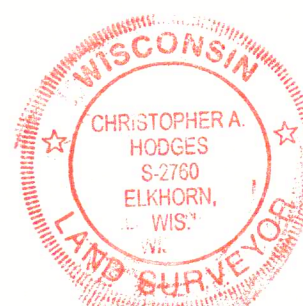

005-3796
STFV-71

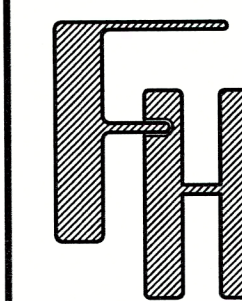

PLAT OF SURVEY

WORK ORDERED BY -
BELVIDERE PARK ASSOCIATION
2323 E CAPITOL DRIVE
MILWAUKEE, WI 53211

FARRIS, HANSEN & ASSOCIATES, INC.

ENGINEERING - ARCHITECTURE - SURVEYING

7 RIDGWAY COURT P.O. BOX 437
ELKHORN, WISCONSIN 53121

OFFICE: (262) 723-2098 e-mail: office@farris-hansen.com

REVISIONS

PROJECT NO.
7656.24

DATE
05/07/2024

SHEET NO.
1 OF 1