

# GEORGE T. DUNHAM

SURVEYING & SUBDIVIDING  
DELAVER, WISCONSIN

DUNLAP

AVENUE

40.98

LOT 4

PORCH

HOUSE

N

Scale - 1" = 10'  
o = Iron Pipe


STATE OF WISCONSIN)  
COUNTY OF WALWORTH)SS

I, George T. Dunham, Surveyor, certify that I have surveyed the property described as follows,  
Lot 4, Block 12 of Glenwood Springs, a subdivision located in the Village of Fontana, Walworth County, Wisconsin,

and the above map is a true representation thereof and shows the size and location of the property, its exterior boundaries, the location and dimensions of all structures thereon, fences, apparent easements and roadways and visible encroachments, if any.

This survey is made for the exclusive use of the present owners of the property, and also those who purchase, mortgage, or guarantee the title thereto within one (1) year from date hereof; and as to them I warrant the accuracy of said survey and map.  
December 29, 1975

*George T. Dunham*  
George T. Dunham, Surveyor

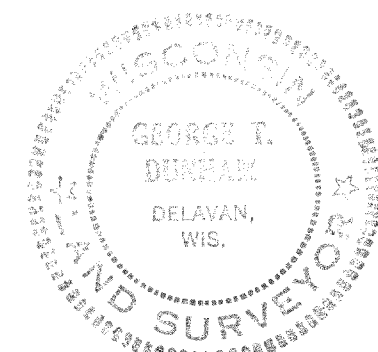

Iron Pipe located 1.4' South of North edge of black top.

WALNUT PLACE

Eaves extend 0.35' West of lot line.

505-62