


HAROLD H. KOLB

REGISTERED PROFESSIONAL LAND SURVEYOR
LAKE GENEVA, WISCONSIN

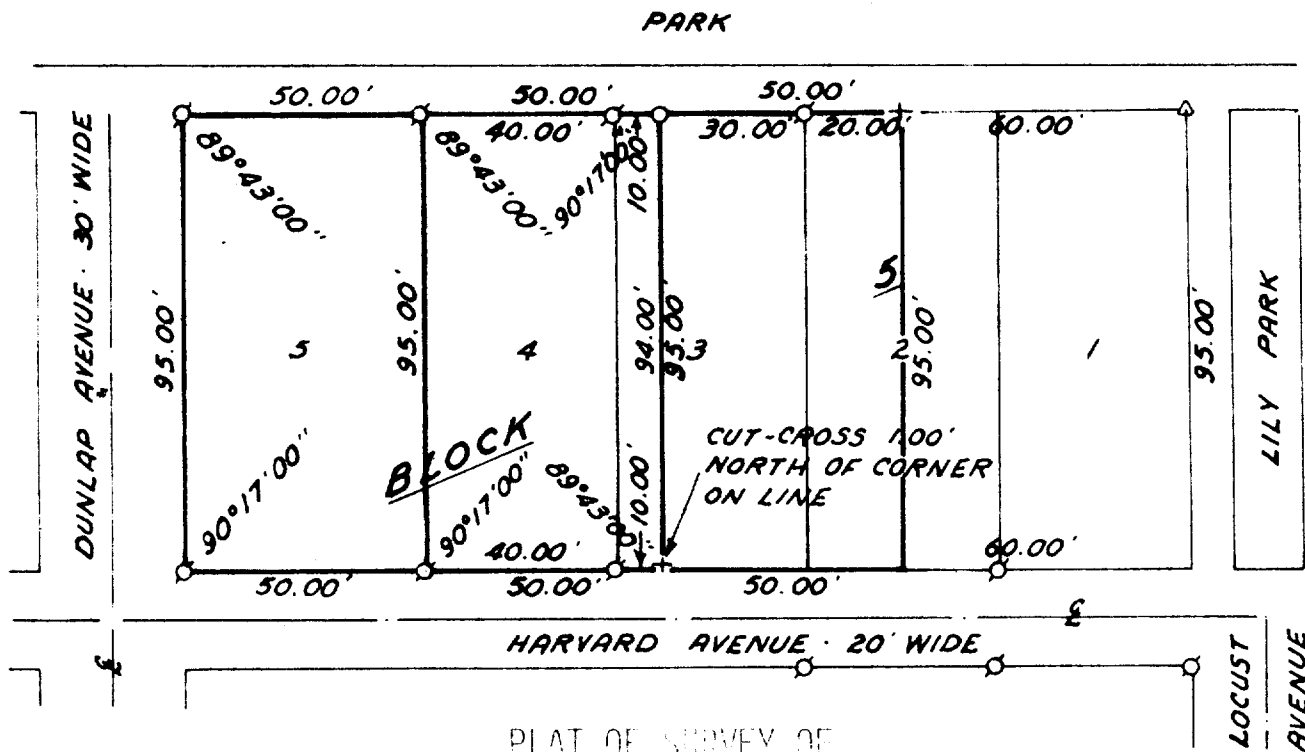

LOTS 3, 4, AND 5, AND THE WEST 1/2 OF
LOT 2, BLOCK 5, GLENWOOD SPRINGS SUB-
DIVISION, VILLAGE OF FONTANA-ON-GENEVA
LAKE, WALWORTH COUNTY, WISCONSIN.

N



SCALE: 1"=40'

LEGEND

- φ — IRON PIPE FOUND
- — IRON PIPE PLACED
- — CONCRETE MONUMENT
- x — SPIKE
- △ — IRON ROD FOUND
- () — PLATTED AS

ORDERED BY: EPISCH CONTRACTING SERVICE

ACCURACY: DISTANCES: ±0.01'
ANGLES: ±05"
ERROR OF CLOSURE: LESS
THAN ONE PART IN 3000


I, HAROLD H. KOLB, DO HEREBY CERTIFY THAT I HAVE
SURVEYED THE PROPERTY HEREON DESCRIBED ACCORDING
TO THE OFFICIAL RECORDS, AND THAT THE PLAT HEREON
IS A CORRECT REPRESENTATION OF THE LOT LINES.

Harold H. Kolb

HAROLD H. KOLB
WISCONSIN REGISTERED LAND SURVEYOR, S-187

DATE May 19, 1976
REVISED: MAY 20, 1976

+ — CUT-CROSS

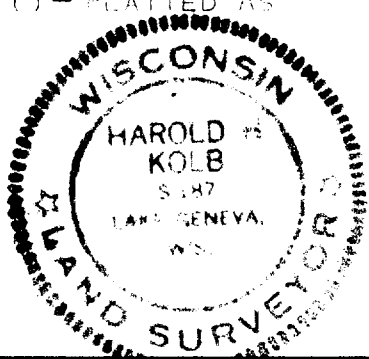

5-438