

PLAT OF SURVEY

OF


UNIT 50 OF ABBEY SPRINGS

A parcel of land located in the South $\frac{1}{2}$ of Section 13, T1N R16E, Village of Fontana-on-Geneva Lake, Walworth County, Wisconsin, being more particularly described as follows:

Beginning at the Southeasterly corner of Unit 49 of Abbey Springs, thence N $29^{\circ}07' E$ 203.63 feet, thence S $88^{\circ}33' E$ 118.00 feet, thence S $0^{\circ}55' W$ 61.80 feet, thence S $46^{\circ}25' W$ 226.82 feet, thence N $1^{\circ}18' E$ 19.44 feet, thence N $65^{\circ}25' W$ 57.32 feet to the place of beginning, containing 0.5569 acres more or less.

Residence Located As Shown 17 June 1975

South Shore Drive

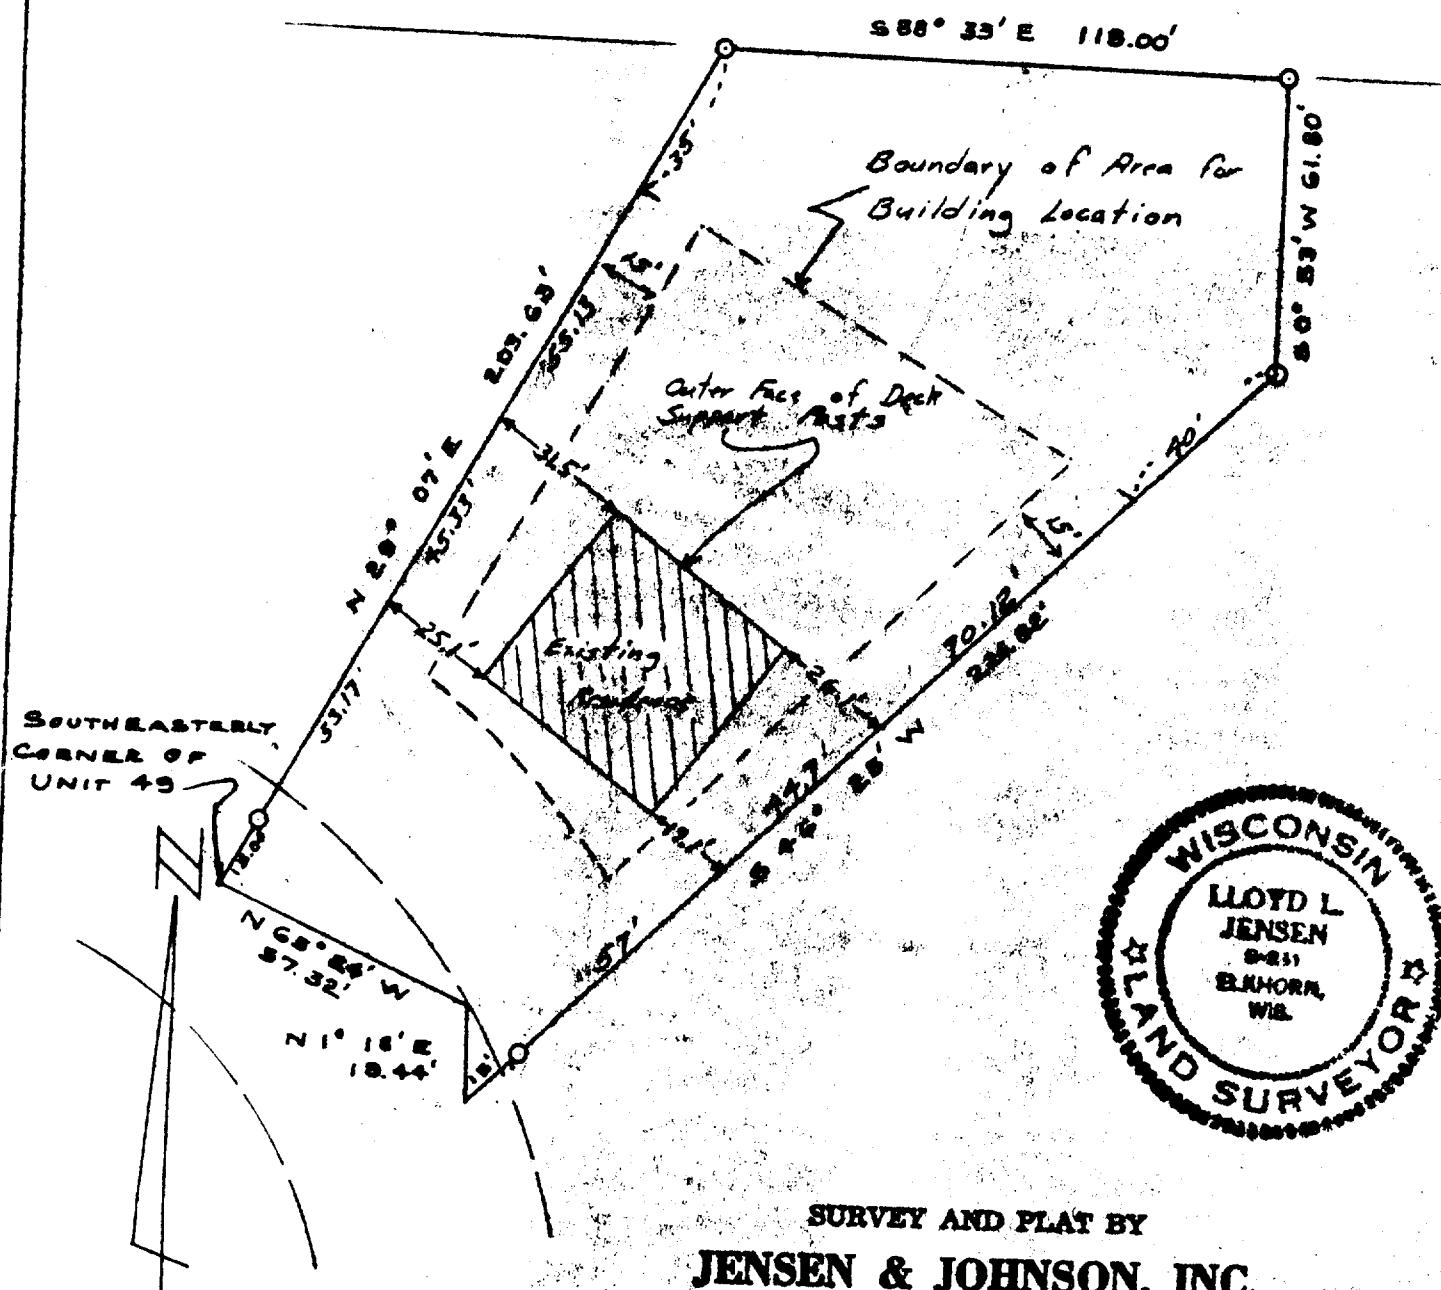

LEGEND

- — Iron Pipe SET
- — Concrete Monument
- Scale 1" = 40'

WE CERTIFY: That we have surveyed the above described property and that the plat shown herein is an accurate survey and a true representation thereof and correctly shows the exterior boundary lines and all divisions of said property.

Date Aug. 1971
Revised 24 June 1975

Lloyd L. Jensen
LLOYD L. JENSEN,
Wisconsin Registered Land Surveyor, No. S-211


PLAT OF SURVEY

OF

UNIT 51 'F' ABBEY SPRINGS

A parcel of land located in the South 1/4 of Section 10, T11N R10E, Village of Montaña-on-Geneva Lake, Walworth County, Wisconsin, being more particularly described as follows:

Beginning at the most Southerly corner of Unit 50 of Abbey Springs, thence N46°-25'E 226.82 feet, thence S 0°-55' E 152.00 feet, thence S66°-18' E 178.54 feet, thence N1°-18'E 67.34 feet to the place of beginning, containing .4073 acres more or less.

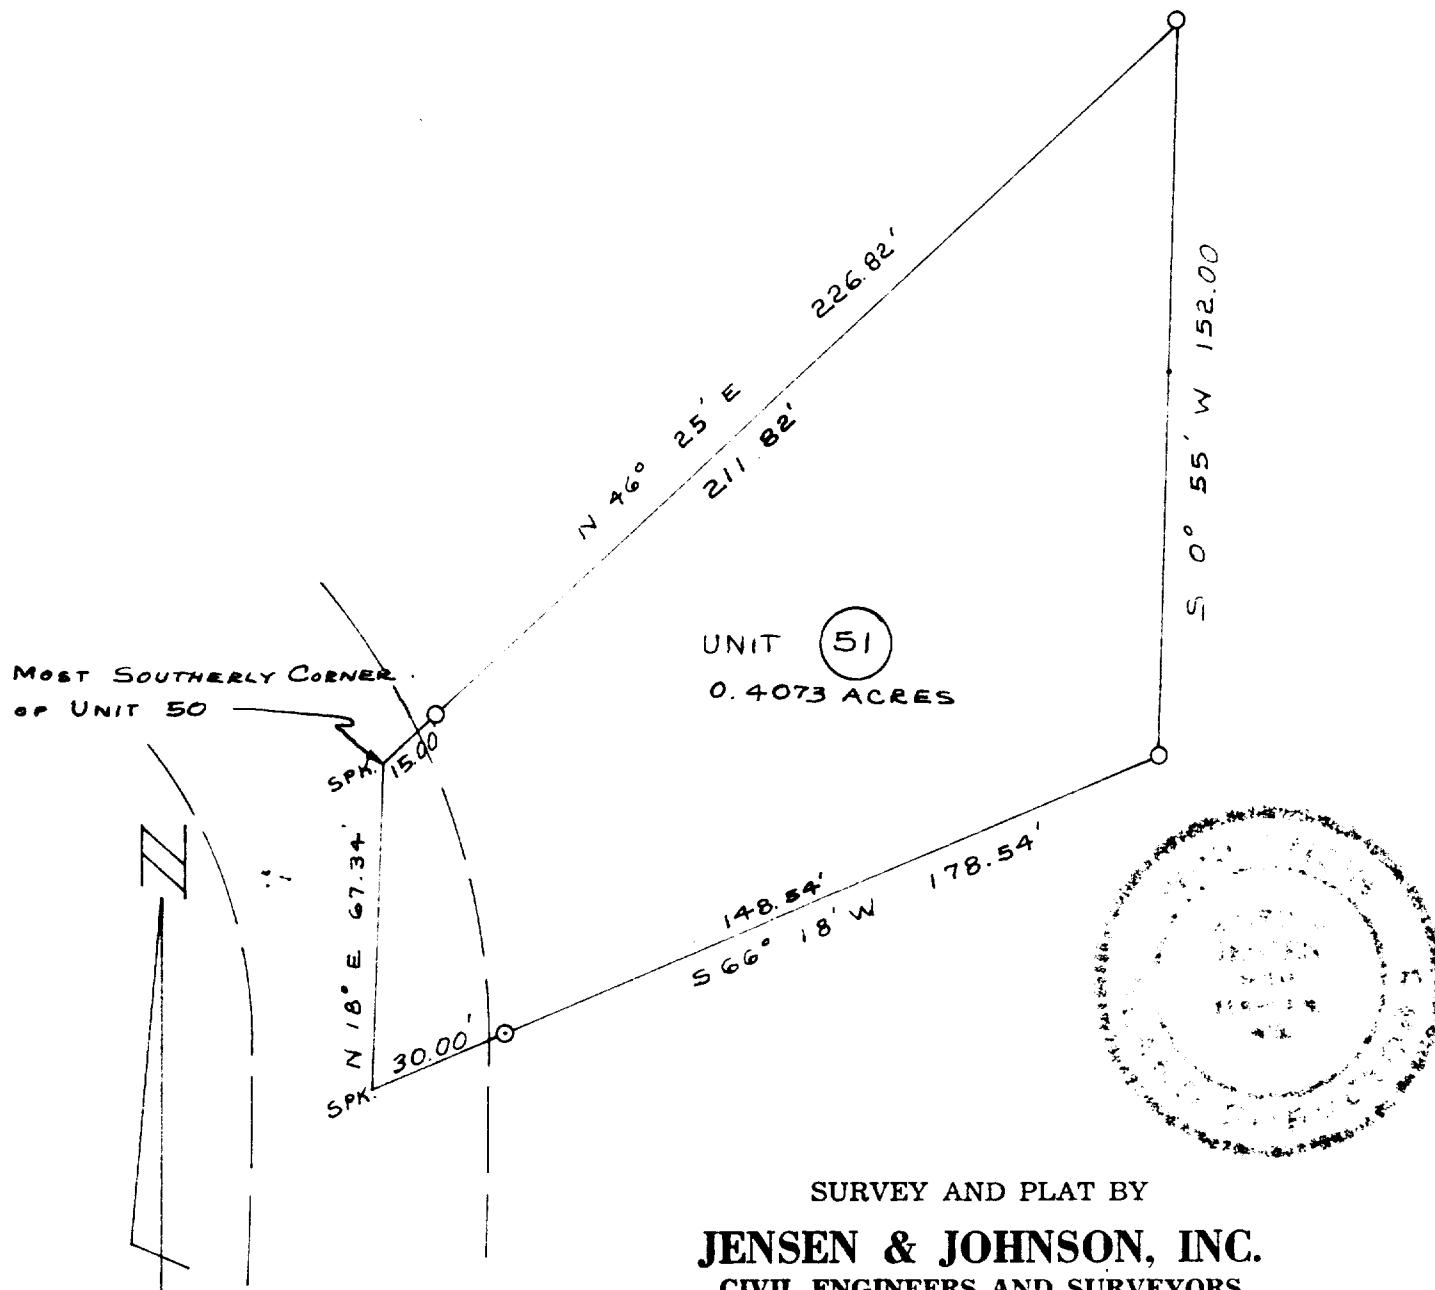

SURVEY AND PLAT BY

JENSEN & JOHNSON, INC.
CIVIL ENGINEERS AND SURVEYORS

Elkhorn, Wisconsin

LEGEND

- — Iron Pipe SET
- — Concrete Monument
- Scale 1" = 40'

WE CERTIFY: That we have surveyed the above described property and that the plat shown hereon is an accurate survey and a true representation thereof and correctly shows the exterior boundary lines and all divisions of said property.

Date AUG 1971

Lloyd L. Jensen
LLOYD L. JENSEN,
Wisconsin Registered Land Surveyor, No. S-211