


DUNHAM SURVEYING, S. C.
 SURVEYING & SUBDIVIDING
 DELAVAN, WISCONSIN 53115

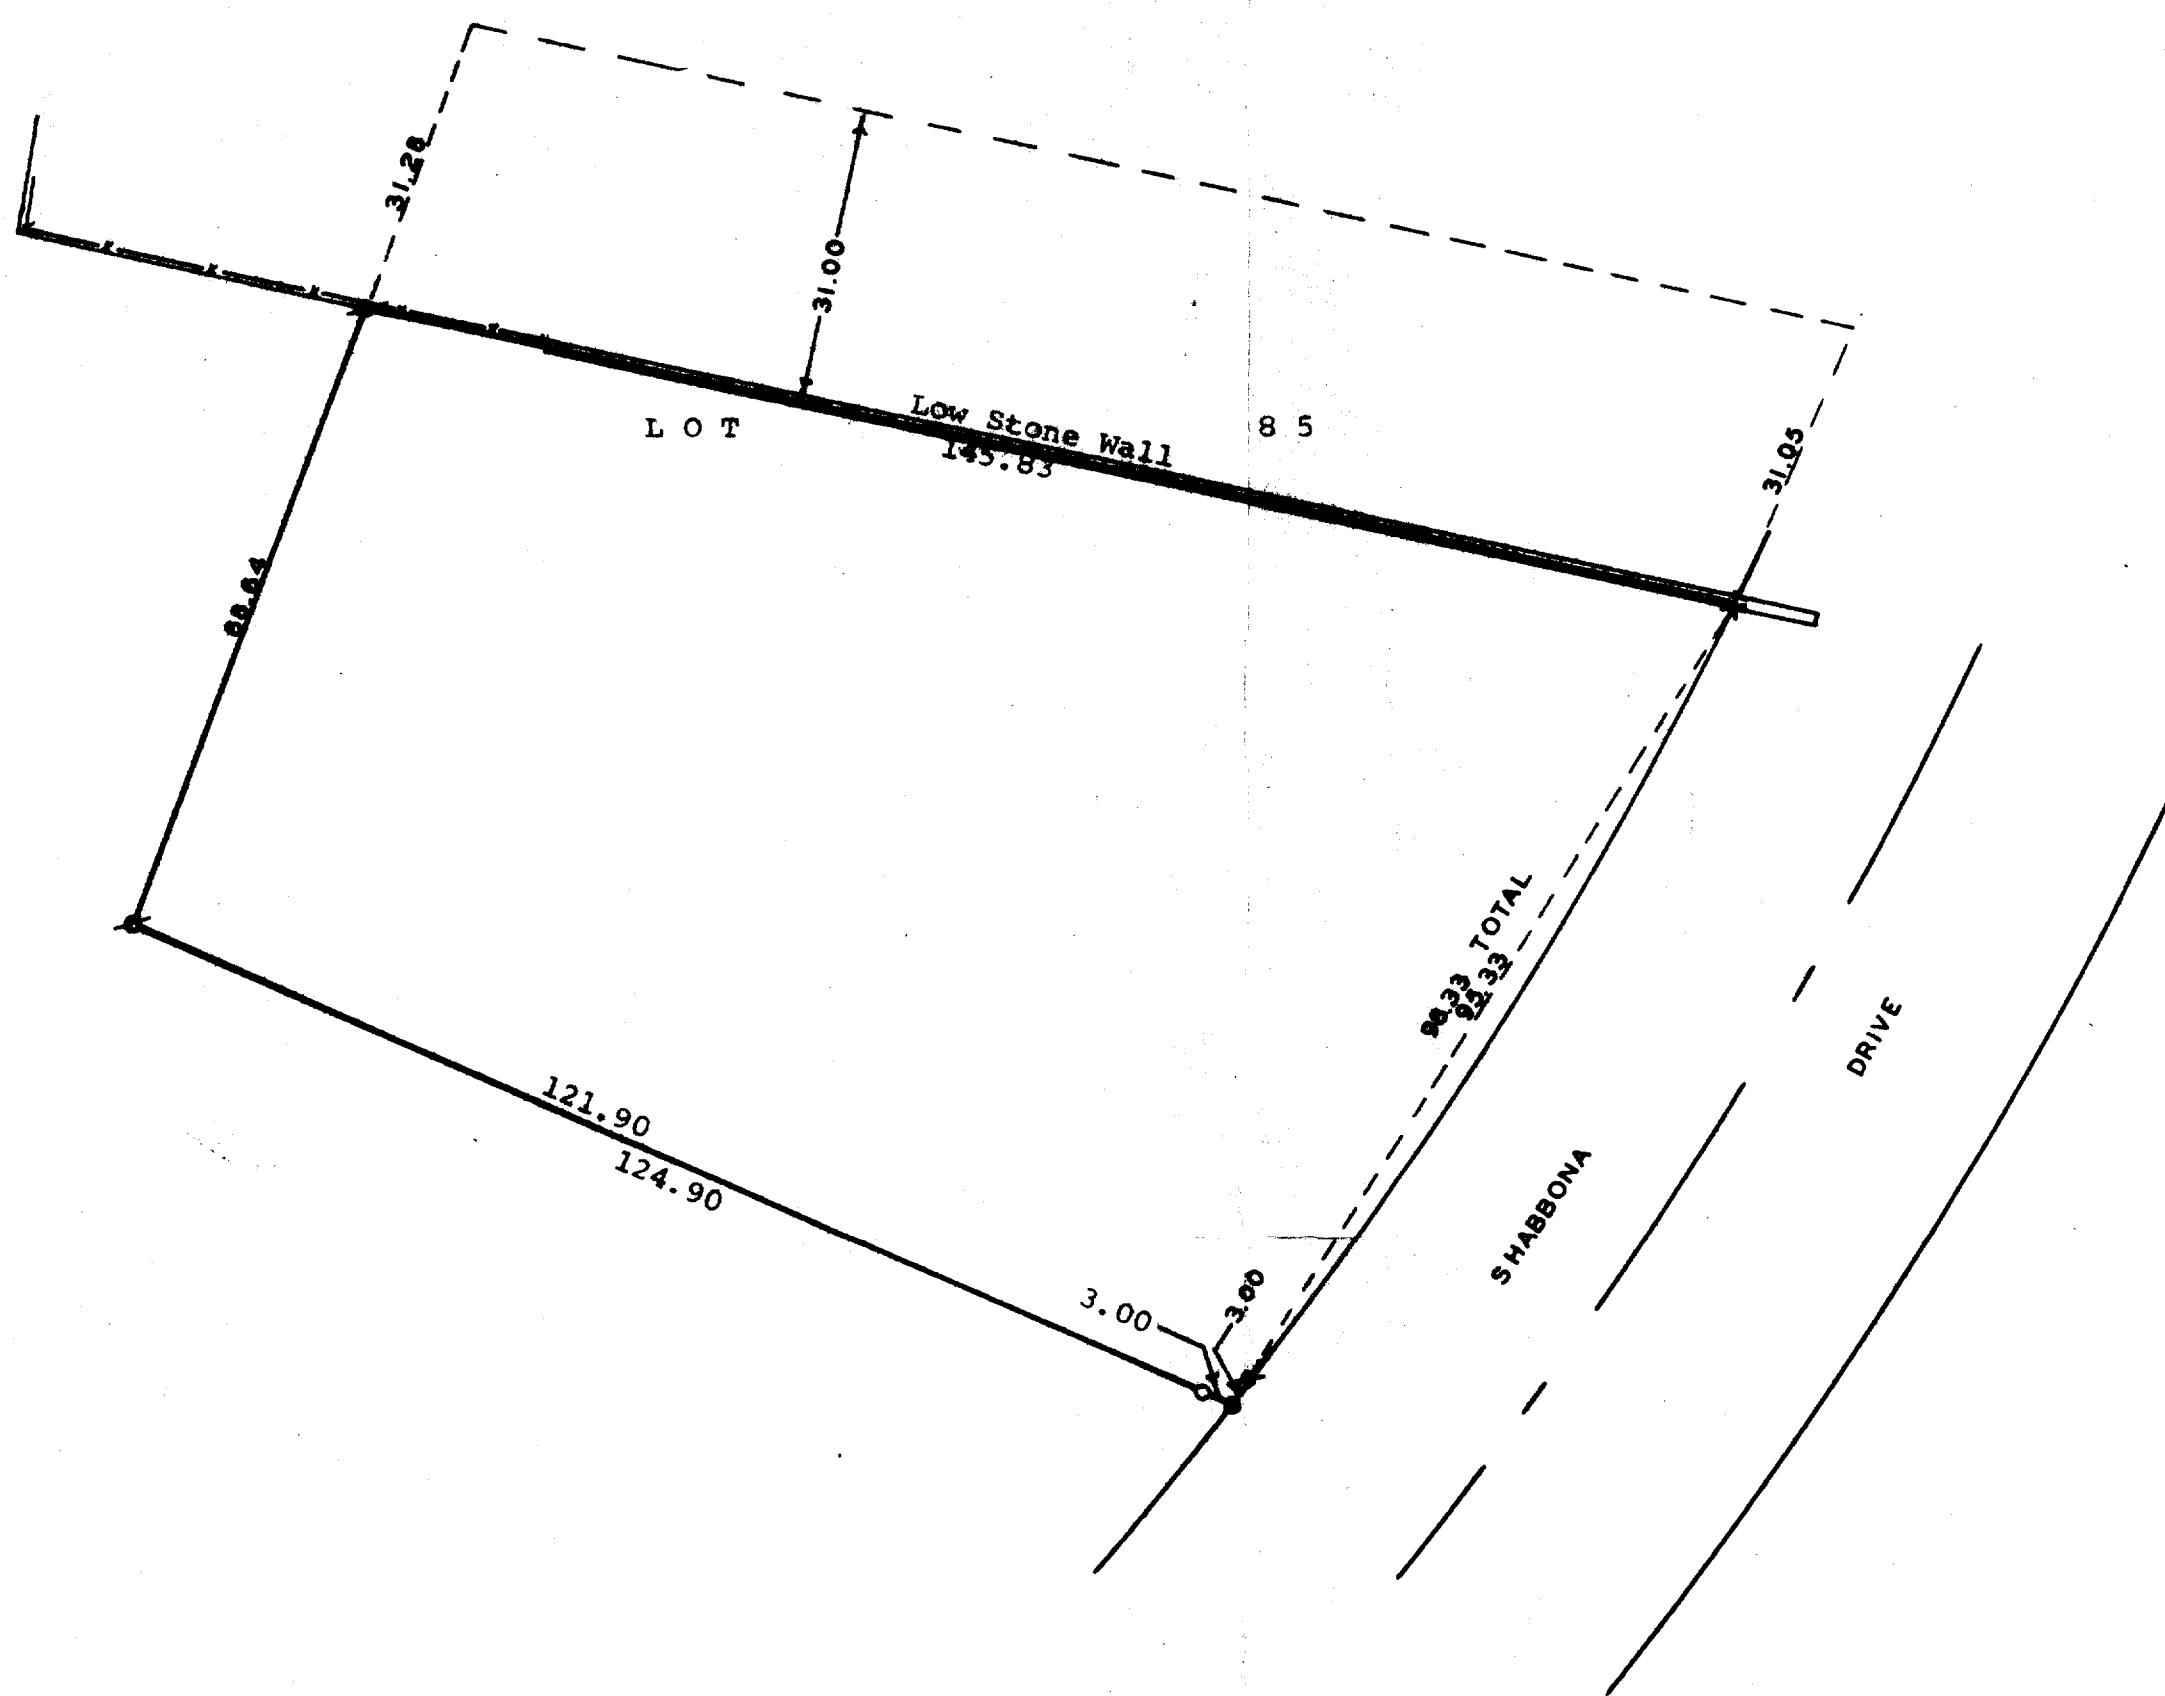

Scale - 1" = 20'
 Ø = Iron Pipe Found
 ○ = Iron Pipe Set
 ● = Power Pole
 -x- = Fence Line
 X = Cross in Concrete

STATE OF WISCONSIN)
 COUNTY OF WALWORTH) SS

I, George T. Dunham, Surveyor, certify that I have surveyed the property described as follows,
 Lot 85 excepting the Northerly 31.00 feet thereof, in Unit No. 2 of Country Club Estates, Village of Fontana on Geneva Lake, Walworth County, Wisconsin,

and the above map is a true representation thereof and shows the size and location of the property, its exterior boundaries, the location and dimensions of all structures thereon, fences, apparent easements and roadways and visible encroachments, if any.

This survey is made for the exclusive use of the present owners of the property, and also those who purchase, mortgage, or guarantee the title thereto within one (1) year from date hereof; and as to them I warrant the accuracy of said survey and map.

April 5, 1977

George T. Dunham
 George T. Dunham, Surveyor

