


2 copies

# PLAT OF SURVEY

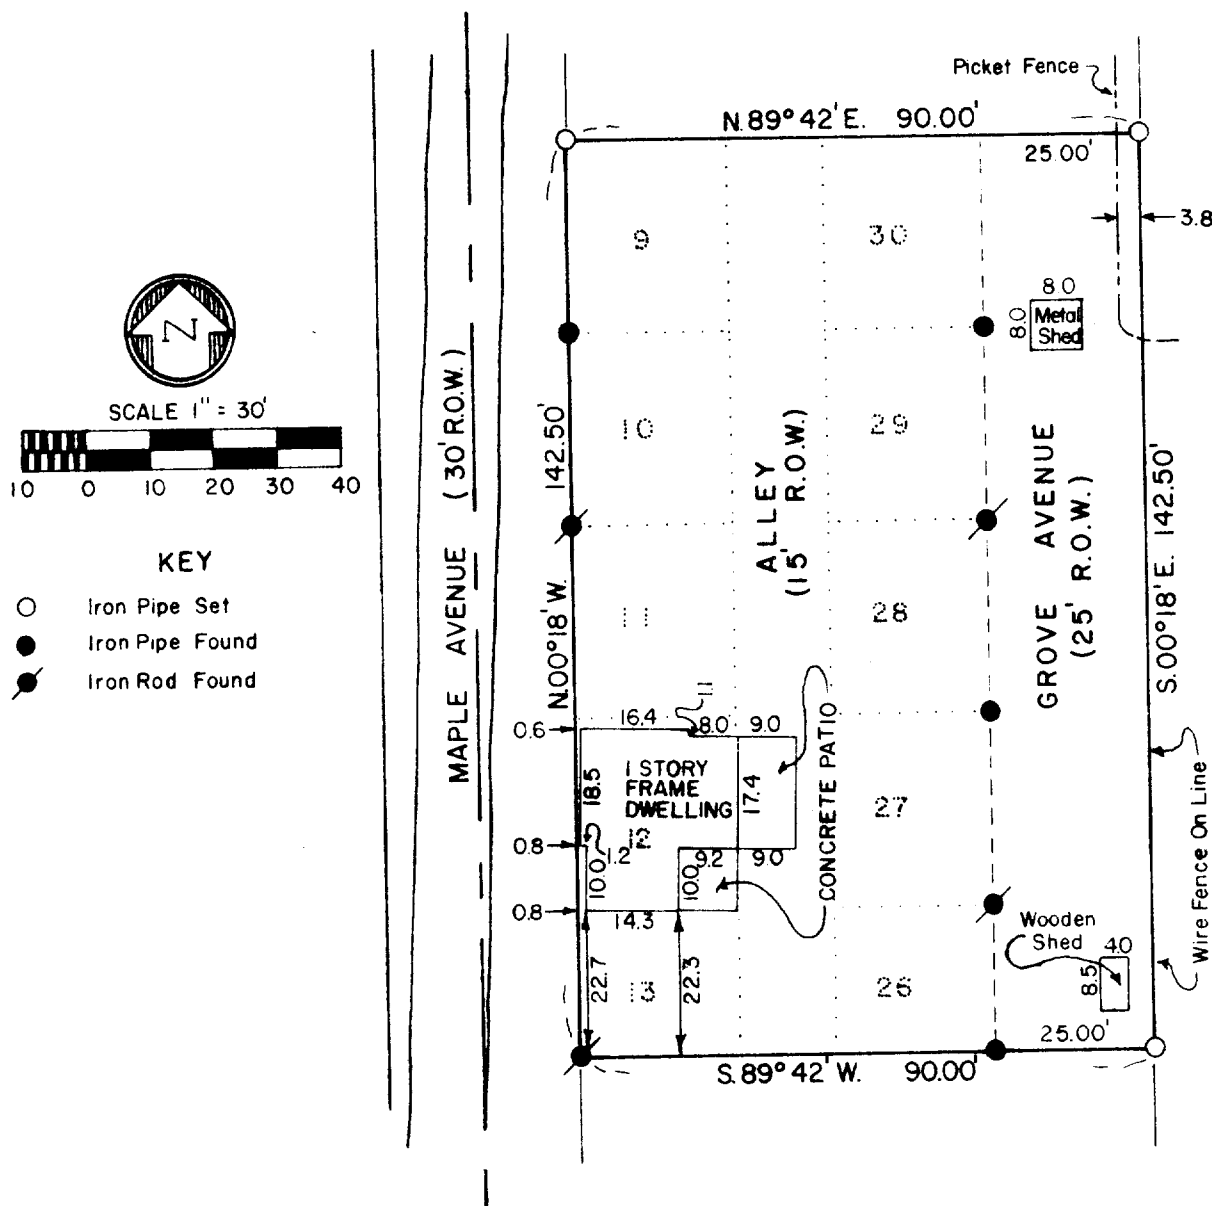

DESCRIPTION:  
Lots 9, 10, 11, 12, 27, 28, 29, 30 and the north 22.5 feet of  
Lots 13 and 26, of Addition to Glenwood Springs Subdivision, a  
part of the SE Fractional 1/4 of Section 14, Township 1 North,  
Range 16 East, 4th Principal Meridian in the Village of Fontana,  
Walworth County, Wisconsin.

SURVEYOR'S CERTIFICATE  
I have surveyed the above described property and the above map is  
a true representation thereof and shows the size and location of the  
property, its exterior boundaries, the location and dimensions of all  
visible structures thereon, fences, apparent easements and roadways and  
visible encroachments. This survey is made for the exclusive use of  
the present owners of the property, and also those who purchase,  
mortgage, or guarantee the title thereto within one (1) year from date  
hereof and as to them I warrant the accuracy of said survey and map.

Date August 31, 1977 Dennis W. Valentine  
Dennis W. Valentine, RLS 1419

Surveyor's Office  
**COPY**

Prepared By VALENTINE AND ASSOCIATES, INC. DELAVER, WISCONSIN	Prepared For ROBERT HAGAN CHICAGO, ILLINOIS	Date 8/30/77	Sheet Number 1 of 1
		Job Number 7770	Reference File

GSA-5 GSA-13

5-481