


HAROLD H. KOLB



REGISTERED PROFESSIONAL LAND SURVEYOR
LAKE GENEVA, WISCONSIN

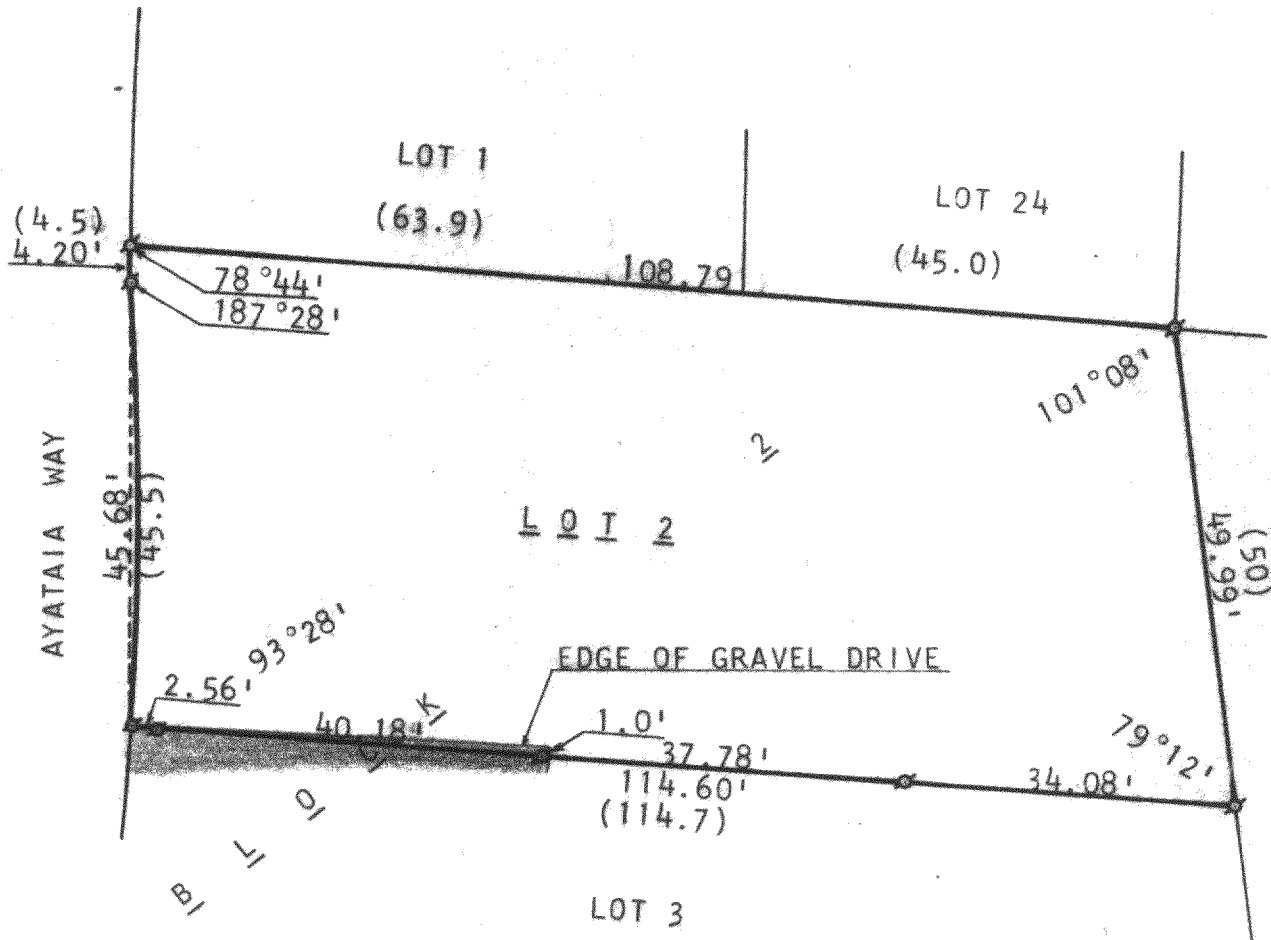

PLAT OF SURVEY OF

LOT 2, BLOCK 2, INDIAN HILLS SUBDIVISION, VILLAGE
OF FONTANA, WALWORTH COUNTY, WISCONSIN.

ORDERED BY: CENTURY 21-BLVD. REALTY
P. O. B. 248
FONTANA, WIS.

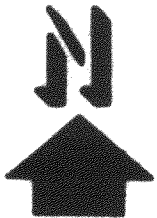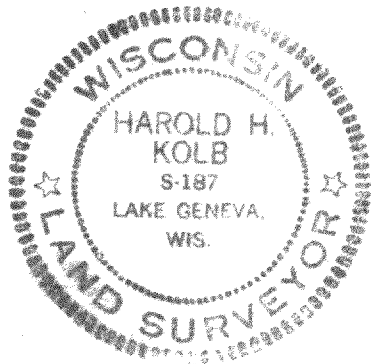

SCALE: 1"=20'

LEGEND

○ — IRON PIPE PLACED, 1" x 24" 1.13 LB./LIN. FT.

● — CONCRETE MONUMENT, 5" DIA. x 30"

⊙ — IRON PIPE FOUND () — AS PLATTED

I, HAROLD H. KOLB, DO HEREBY CERTIFY THAT
I HAVE SURVEYED THE PROPERTY HEREON DE-
SCRIBED ACCORDING TO THE OFFICIAL RECORDS,
AND THAT THE PLAT HEREON IS A CORRECT REP-
RESENTATION OF THE LOT LINES.

Harold H. Kolb

HAROLD H. KOLB

WISCONSIN REGISTERED LAND SURVEYOR, S-187

DATE July 25, 1978