

WARREN E. HANSEN
PROFESSIONAL ENGINEER

FARRIS, HANSEN & COOPER, INC.

ENGINEERING, SURVEYING AND LAND PLANNING
715 W. WALWORTH ST. - P.O. BOX 487 - ELKHORN, WI 53121
OFFICE: 414/723-2088

DANIEL D. COOPER
ROBERT A. FARRIS
LAND SURVEYOR

ENGINEERING
MUNICIPAL - STRUCTURAL
HIGHWAYS - PUBLIC WORKS

MORTGAGE INSPECTION SURVEY



SURVEYING & PLANNING
SUBDIVISIONS - LOT SURVEYS
CONSTRUCTION STAKING - MAPPING

LEGEND

- - IRON PIPE FOUND
- - CONC. MON. FOUND
- () - RECORD DIMENSION



SCALE: 1"=40'

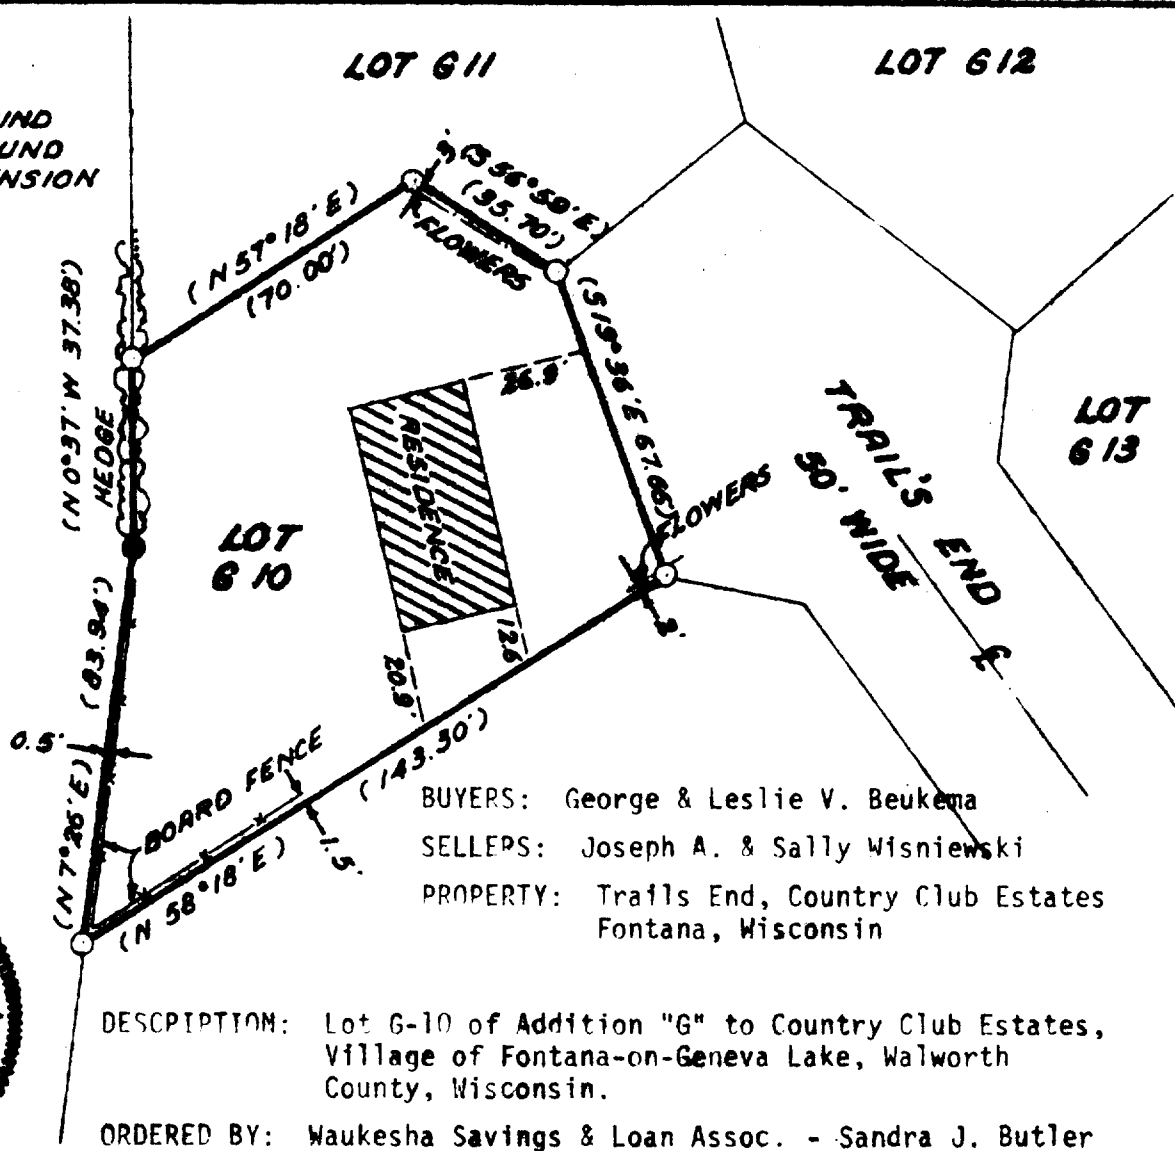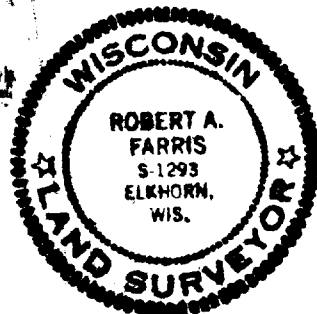

NOTE: THIS IS NOT A "PROPERTY SURVEY" AS DEFINED IN SEC. AE 5.01 OF THE
WISCONSIN ADMINISTRATIVE CODE.

I HEREBY CERTIFY that this map is a true representation of the Lot Lines
and the buildings located hereon to the best of my knowledge and belief.

Dated this 28th Day of August, 1978.

Robert A. Farris
Robert A. Farris, RLS

SGT 6-10

5-528

NO. 1387