

# FARRIS, HANSEN & COOPER, INC.

ENGINEERING, SURVEYING AND LAND PLANNING  
715 W. WALWORTH ST. - P.O. BOX 487 - ELKHORN, WI 53121  
OFFICE: 414/723-2088

DANIEL D. COOPER  
ROBERT A. FARRIS  
LAND SURVEYOR

WARREN E. HANSEN  
PROFESSIONAL ENGINEER

ENGINEERING  
MUNICIPAL - STRUCTURAL  
HIGHWAYS - PUBLIC WORKS

## MORTGAGE INSPECTION SURVEY

SURVEYING & PLANNING  
SUBDIVISIONS - LOT SURVEYS  
CONSTRUCTION STAKING - MAPPING

### LEGEND

- - IRON PIPE FOUND
- - CONC. MON. FOUND
- ( ) - RECORD DIMENSION

LOT 611

LOT 612

LOT 610

LOT 613

(N 0° 37' W 37.38')

(83.94')

0.5'

(N 7° 26' E)

(N 58° 18' E)

(143.30')

BOARD FENCE

11.5'

20.9'

12.8'

26.9'

(S 19° 36' E 67.65')

(S 56° 59' E)

(35.70')

(N 57° 18' E)

(70.00')

BUYERS: George & Leslie V. Beukema

SELLEPS: Joseph A. & Sally Wisniewski

PROPERTY: Trails End, Country Club Estates  
Fontana, Wisconsin

DESCRIPTION: Lot 6-10 of Addition "G" to Country Club Estates,  
Village of Fontana-on-Geneva Lake, Walworth  
County, Wisconsin.


ORDERED BY: Waukesha Savings & Loan Assoc. - Sandra J. Butler

NOTE: THIS IS NOT A "PROPERTY SURVEY" AS DEFINED IN SEC. AE 5.01 OF THE  
WISCONSIN ADMINISTRATIVE CODE.

I HEREBY CERTIFY that this map is a true representation of the Lot Lines  
and the buildings located hereon to the best of my knowledge and belief.

Dated this 28th Day of August, 1978.

*Robert A. Farris*  
Robert A. Farris, RLS

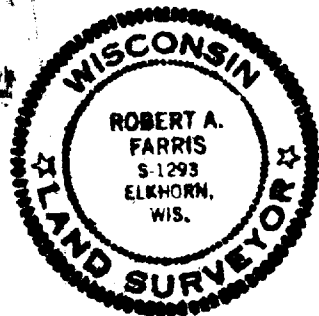

SCALE: 1"=40'

SGT6-10

5-528

NO. 1387