

**WARREN E. HANSEN**  
PROFESSIONAL ENGINEER

ENGINEERING  
MUNICIPAL - STRUCTURAL  
HIGHWAYS - PUBLIC WORKS

**FARRIS, HANSEN & COOPER, INC.**

ENGINEERING, SURVEYING AND LAND PLANNING  
715 W. WALWORTH ST. - P.O. BOX 487 - ELKHORN, WI 53121  
OFFICE: 414/723-2088

**DANIEL D. COOPER**  
**ROBERT A. FARRIS**  
LAND SURVEYOR

SURVEYING & PLANNING  
SUBDIVISIONS - LOT SURVEYS  
CONSTRUCTION STAKING - MAPPING


**MORTGAGE INSPECTION SURVEY**  
Lot 103 in Unit 2 Country Club Estates being located in the Village of Fontana-on-Geneva Lake,  
Walworth County.

Work Ordered By: Waukesha  
Savings & Loan Assoc.

SELLERS: William & Joan  
Baffes

BUYERS: Robert & Carolyn  
Mork

- o Indicates Concrete  
Monument Found

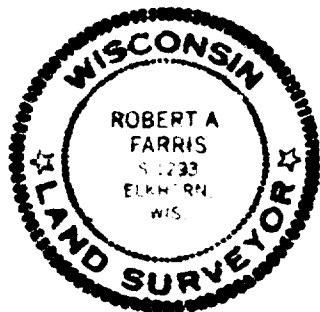

I hereby certify that this map  
is a true and accurate representation  
of the lines described and the location  
of the buildings thereon to the best of  
my knowledge and belief.

*Robert A. Farris*  
Robert A. Farris  
Surveyor No. S-1293

DATED: 29 Aug. 1978

NOTE: THIS IS NOT A "PROPERTY SURVEY" AS DEFINED IN SEC. A-E 5.01 OF THE WISCONSIN  
ADMINISTRATIVE CODE.

