
HAROLD H. KOLB

REGISTERED PROFESSIONAL LAND SURVEYOR LAKE GENEVA, WISCONSIN



PLAT OF SURVEY OF

LOTS 7, 8, 9 AND THE WEST 5 FEET OF LOT 10, BLOCK 5, D.A. REID'S ADDITION TO REID'S PARK, A SUB-DIVISION LOCATED IN THE VILLAGE OF FONTANA-ON-GENEVA LAKE, WALWORTH COUNTY, WISCONSIN.

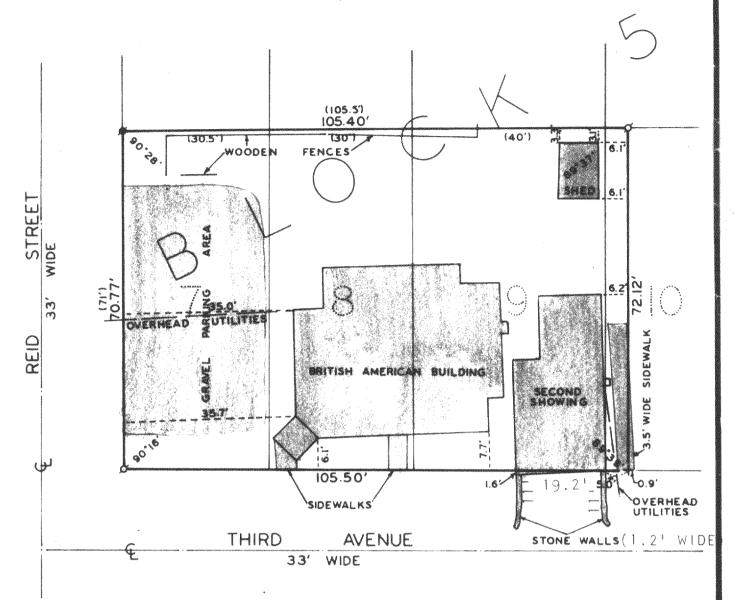

ORDERED BY: CONROYD REALTY HIGHWAY 67 FONTANA, WI 53125

I HAVE SURVEYED THE ABOVE-DESCRIBED PROPERTY AND THE ABOVE MAP IS A TRUE REPRESENTATION THEREOF AND SHOWS THE SIZE AND LOCATION OF THE PROPERTY, ITS EXTERIOR BOUNDARIES, THE LOCATION OF ALL APPARENT EASEMENTS AND ROAD-WAYS AND VISIBLE ENCROACHMENTS, IF ANY.

THIS SURVEY IS MADE FOR THE USE OF THE PRESENT OWNERS OF THE PROPERTY, AND ALSO THOSE WHO PURCHASE, MORTGAGE, OR GUARANTEE THE TITLE THERETO WITHIN ONE (1) YEAR FROM DATE HEREOF.

WISCONSIN REGISTERED LAND SURVEYOR, S-187



SCALE: 1"=20"

+ - CUT CROSS FOUND

O - IRON PIPE PLACED, 1" x 24" 1.13 LB./LIN. FT.

CONCRETE MONUMENT. 5" DIA. x 30" (FOUND)

RON PIPE FOUND ()-AS PLATTED

DATE <u>Dec. 8, 1978</u>

HAROLD H. KOLB

REVISED DEC. 12.1978

5-5546