
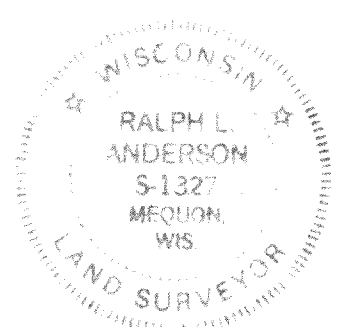


# PLAT OF SURVEY

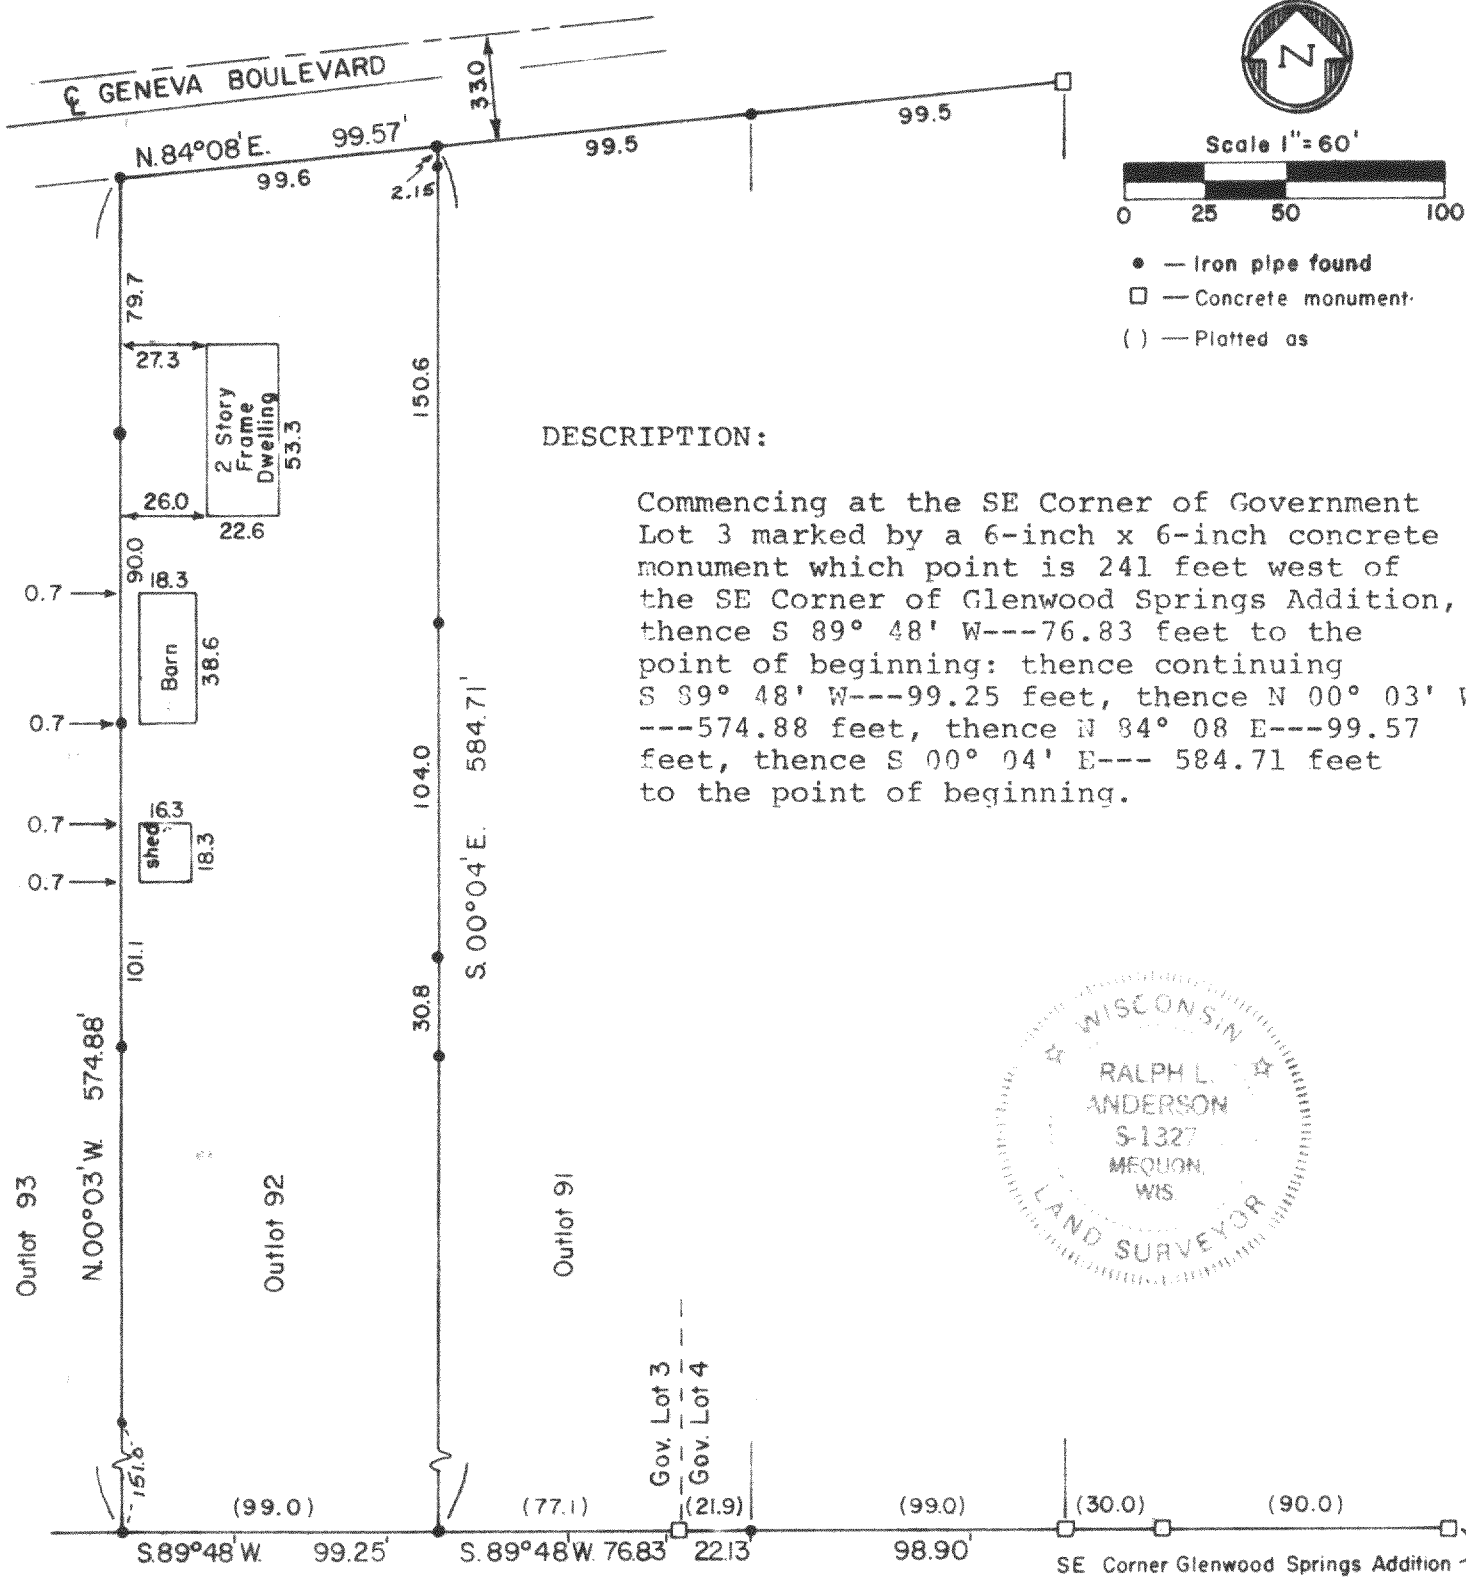

## SURVEYOR'S CERTIFICATE

I have surveyed the above described property and the above map is a true representation thereof and shows the size and location of the property, its exterior boundaries, the location and dimensions of all visible structures thereon, fences, apparent easements and roadways and visible encroachments. This survey is made for the exclusive use of the present owners of the property, and also those who purchase, mortgage, or guarantee the title thereto within one (1) year from date hereof and as to them I warrant the accuracy of said survey and map.

Date 7 July 1977

Ralph L. Anderson  
Ralph L. Anderson, RLS 1327

Prepared By	Prepared For	Date	Sheet Number
VALENTINE AND ASSOCIATES, INC.	ALICE MARLEWSKI	7/7/77	1 of 1
DELAVER, WISCONSIN	FONTANA, WISCONSIN	Job Number	Reference
		7741	File