


KOLB LAND CONSULTING, INC.
 LAND SURVEYING • SUBDIVIDING • LAND PLANNING

LAKE GENEVA, WISCONSIN 53147


WHITEWATER, WISCONSIN 53190

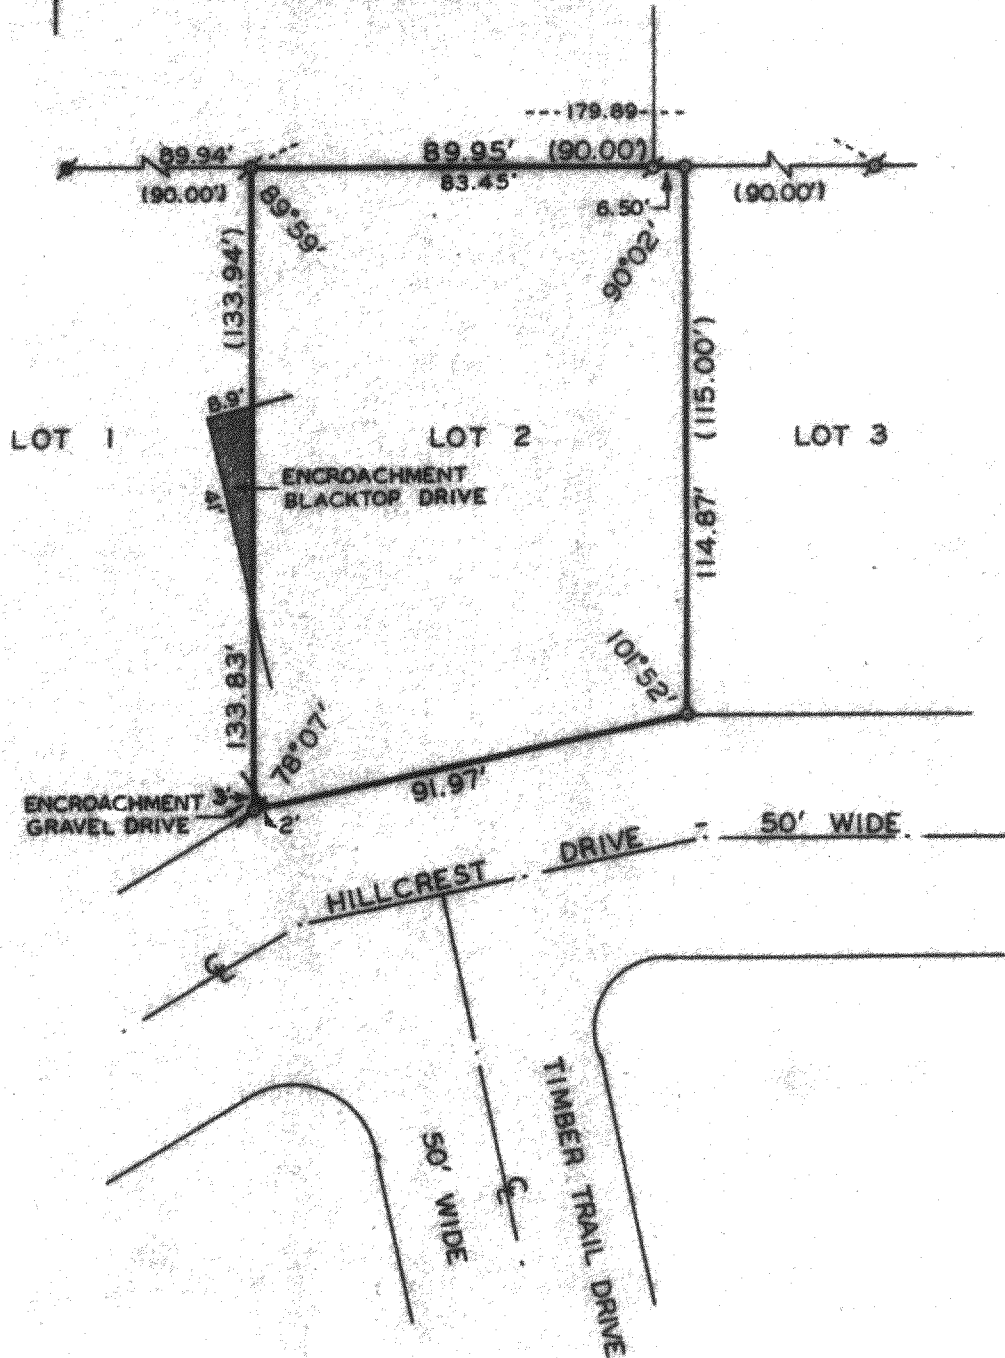

PLAT OF SURVEY OF

LOT 2, ADDITION "D" TO COUNTRY CLUB ESTATES, VILLAGE OF FONTANA-GENEVA LAKE, WALWORTH COUNTY, WISCONSIN.

OWNER: JEFFERY BAKER
 ROUTE 3--BOX 150 C
 FONTANA, WI 53125

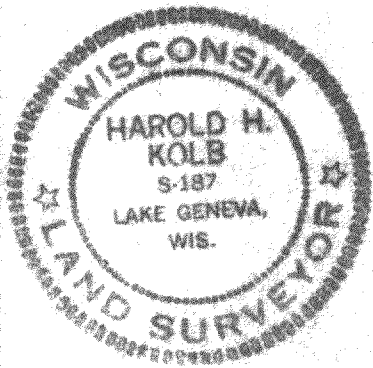

SCALE: 1"=40'

- LEGEND
- () - RECORDED AS
 - - CONCRETE MONUMENT FOUND
 - - IRON PIPE FOUND
 - - IRON PIPE SET

I, HAROLD H. KOLB, DO HEREBY CERTIFY THAT I HAVE SURVEYED THE PROPERTY HEREON DESCRIBED ACCORDING TO THE OFFICIAL RECORDS AND THAT THE PLAT HEREON IS A CORRECT REPRESENTATION OF THE LOT LINES TO THE BEST OF MY KNOWLEDGE AND BELIEF.

Harold H. Kolb

HAROLD H. KOLB
 WISCONSIN REGISTERED LAND SURVEYOR, S-187

DATE May 22, 1980