

# FARRIS, HANSEN & COOPER, INC.

ENGINEERING, SURVEYING AND LAND PLANNING  
715 W. WALWORTH ST. - P.O. BOX 483 - ELKHORN, WI 53121  
OFFICE: 414/723-2088

BELL DRIVE

N 76° 18' E  
159.94' (160.03)

LOT 7

523.55' E  
26.18'

FOUND 1" IRON PIPE  
193.68'

SET 1" IRON PIPE

LOT 8

LOT 9



MAP SCALE  
1" = 30'

N 10° 24' W  
(42.01')

159.85' (160.44')


TOE OF STEEP SLOPE

LOT 18

PLAT of SURVEY  
of  
Lot 8, Addition no. 1, Country Club  
Estates, Village of Fontana, Walworth Co.,  
Wisconsin.

I hereby certify that at the direction  
of Glen Roos I have surveyed Lot 8 and  
that this plat is a true and accurate  
representation thereof.

LOT 17

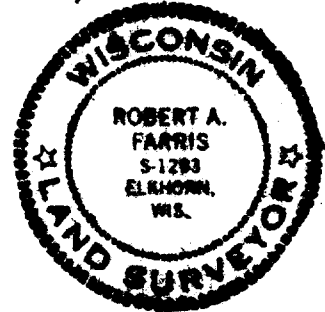

*Robert A. Farris*

Robert A. Farris

MARCH 24, 1983

( ) - RECORD  
DIMENSION

φ - 1 1/4" IRON PIPE  
FOUND

DRAWING NUMBER 2069