


KOLB LAND CONSULTING, INC.
LAKE GENEVA, WISCONSIN

CUT CROSS FOUND
NORTHEAST CORNER LOT 4

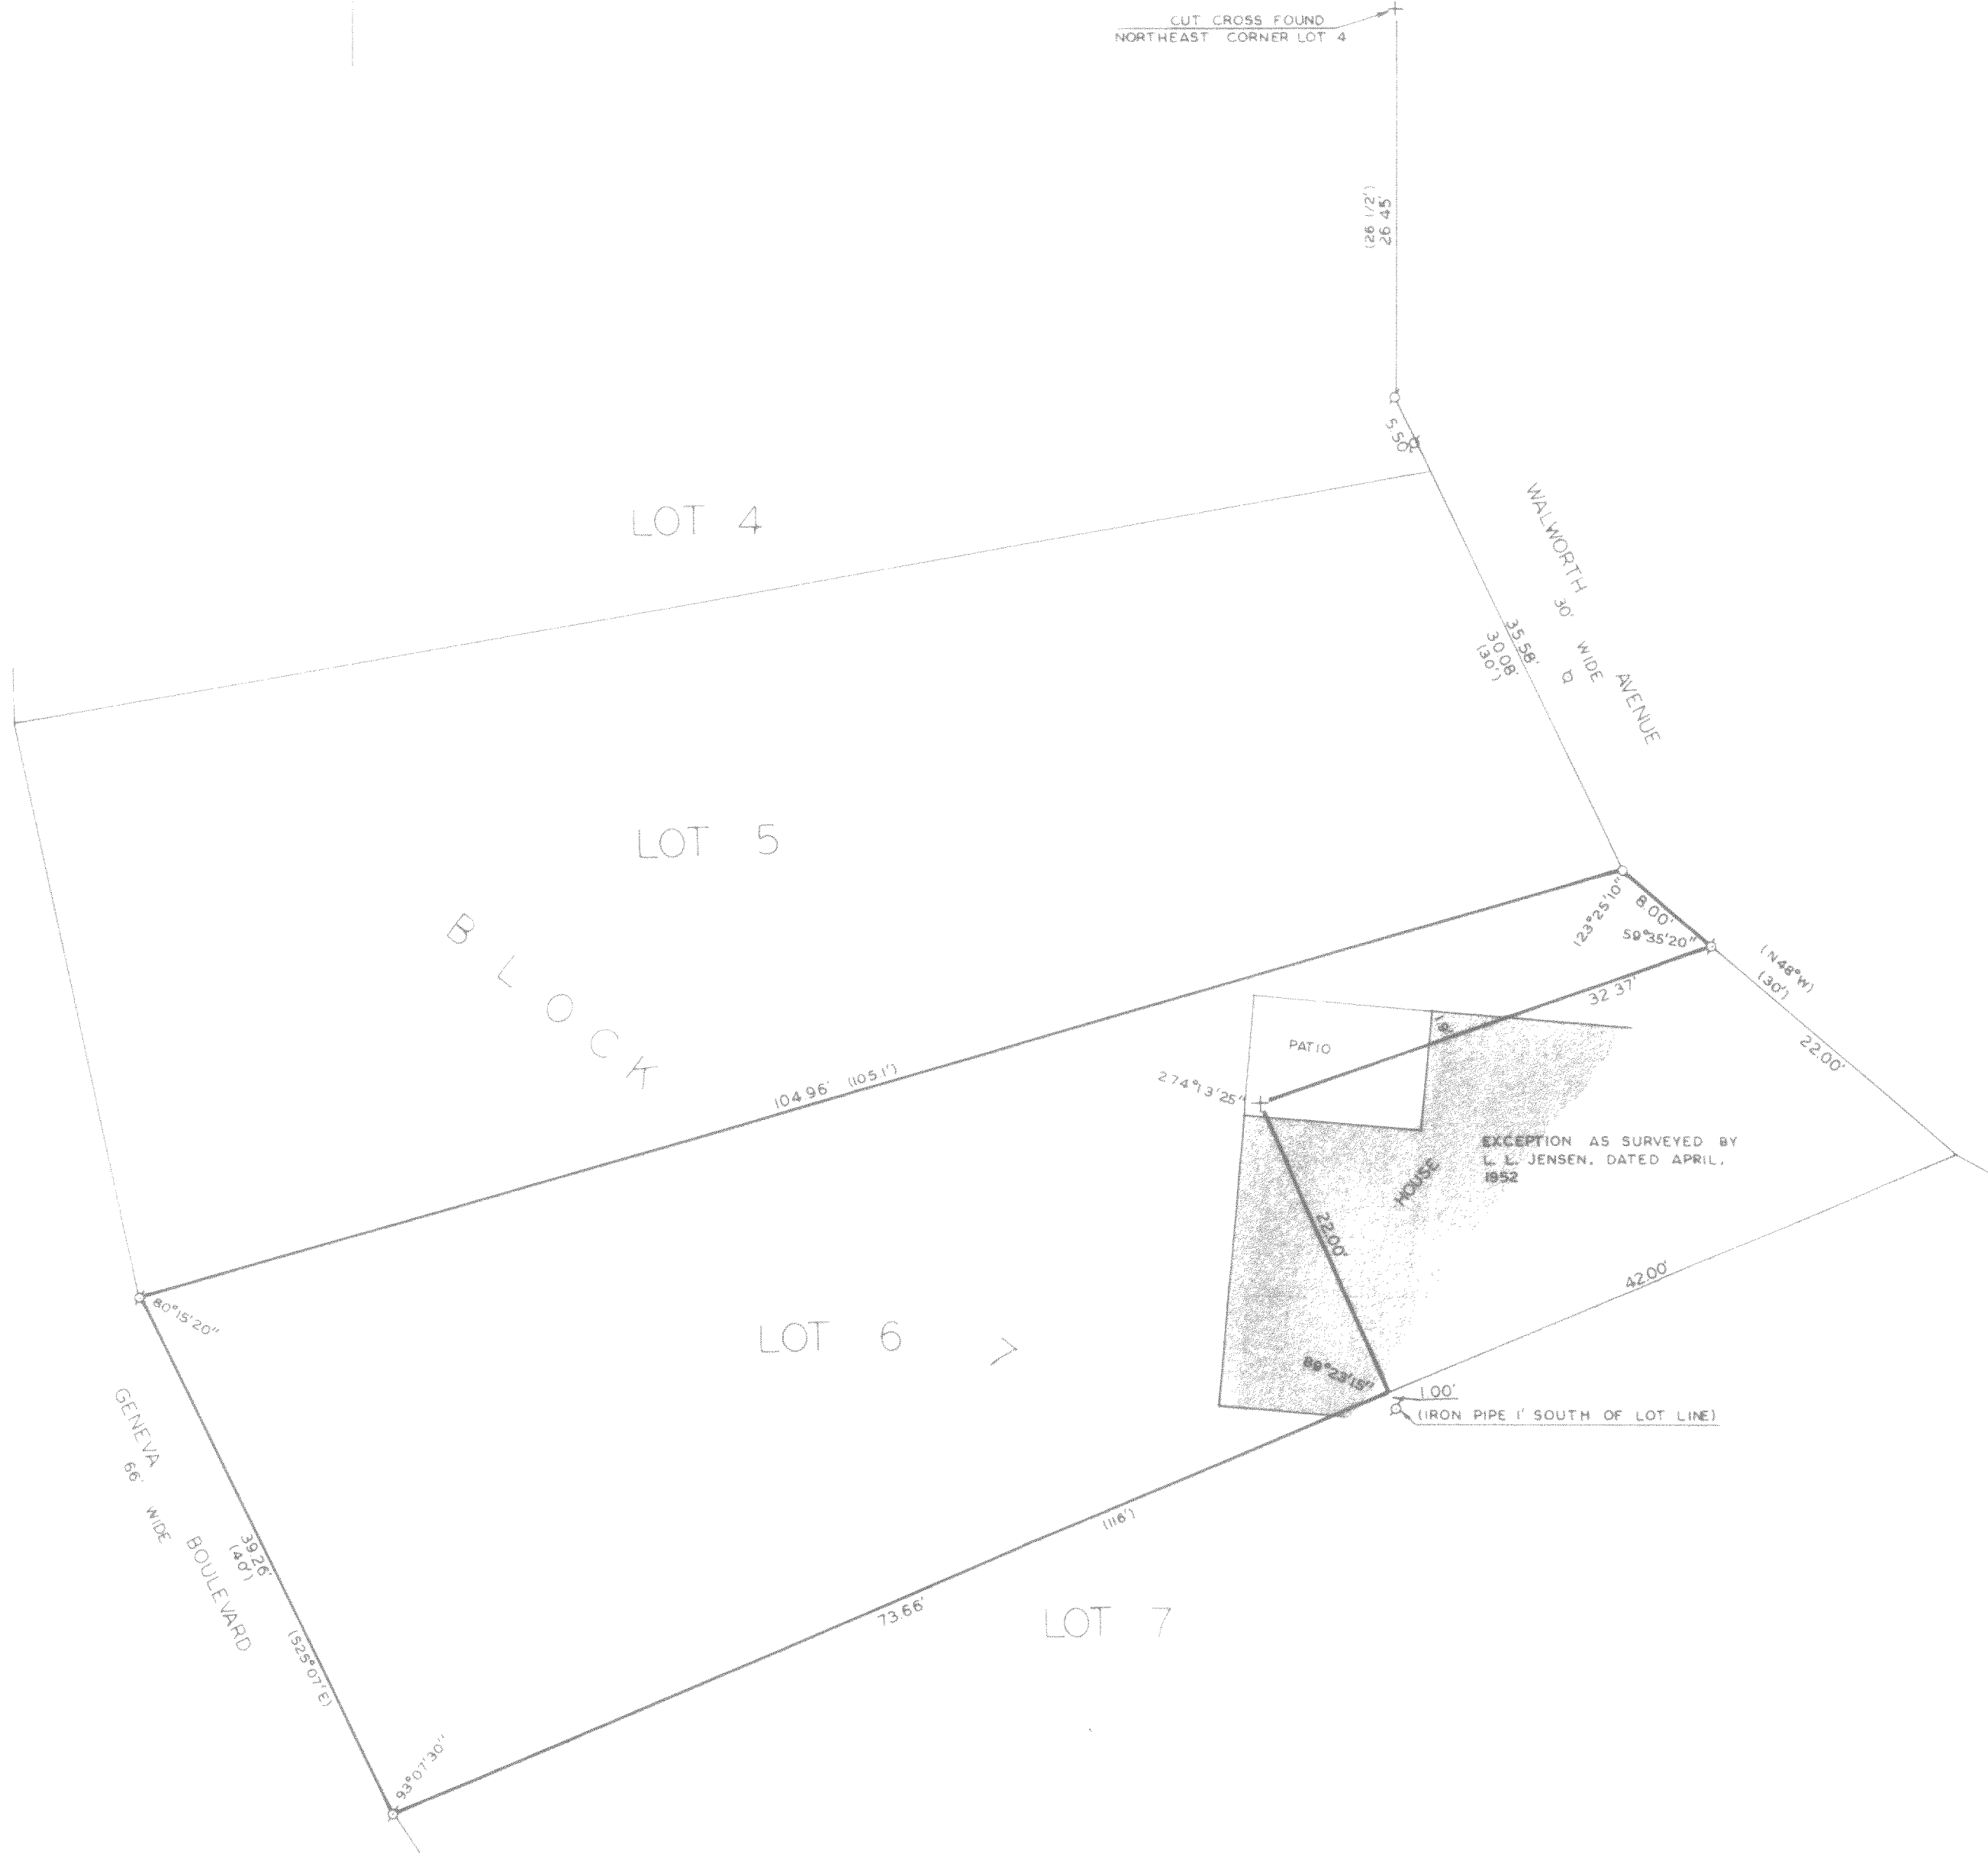


PLAT OF SURVEY OF

PART OF LOT 6, BLOCK 7, GLENWOOD SPRINGS,
A SUBDIVISION LOCATED IN THE VILLAGE OF
FONTANA-ON GENEVA LAKE, WALWORTH COUNTY,
WISCONSIN.


ORDERED BY: TOM RICHOLSON

FOR: GLENWOOD SPRINGS CLUB
P.O. Box 298
FONTANA, WI 53125

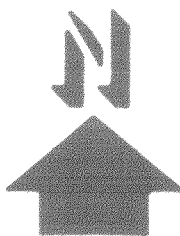

SCALE: 1"=100'

- o - IRON PIPE FOUND
- o - IRON PIPE PLACED
- + - CUT CROSS IN CONCRETE
- () - RECORDED AS

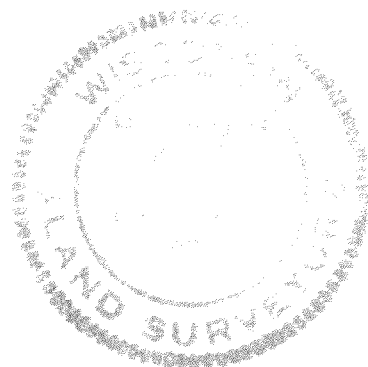

I, HAROLD H. KOLB, DO HEREBY CERTIFY THAT I HAVE
SURVEYED THE PROPERTY HEREON DESCRIBED ACCORDING
TO THE OFFICIAL RECORDS, AND THAT THE PLAT HEREON
IS A CORRECT REPRESENTATION OF THE LOT LINES TO
THE BEST OF MY KNOWLEDGE AND BELIEF.

Harold H. Kolb
HAROLD H. KOLB
WISCONSIN REGISTERED LAND SURVEYOR, 5-187
DATE July 29, 1980