


HAROLD H. KOLB

REGISTERED PROFESSIONAL LAND SURVEYOR
LAKE GENEVA, WISCONSIN

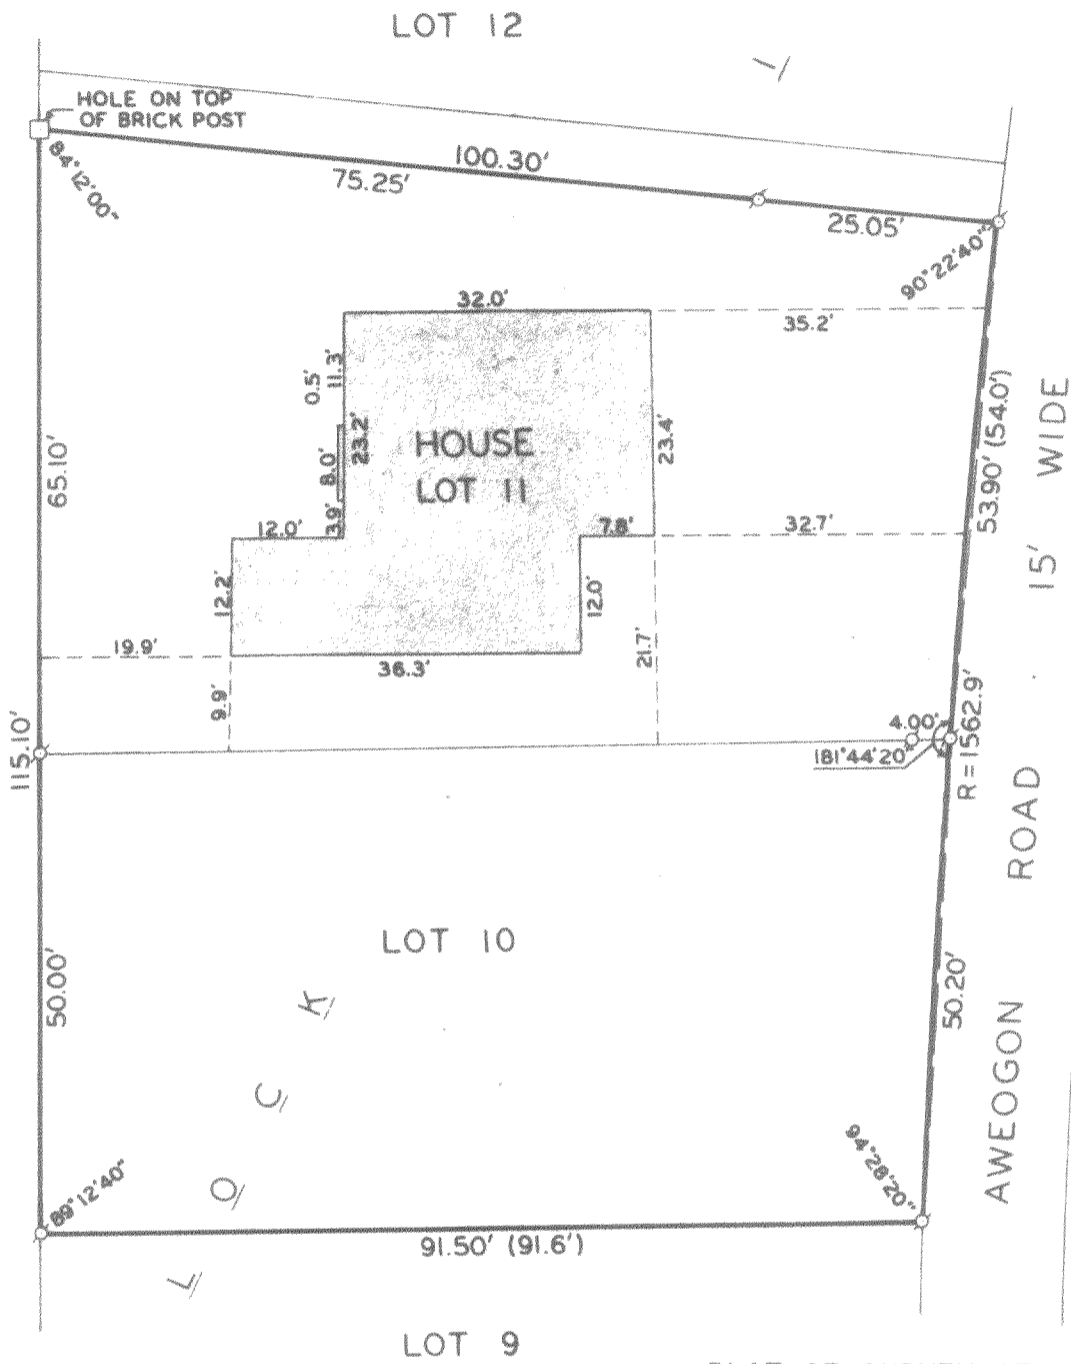

PLAT OF SURVEY OF

LOTS 10 AND 11, BLOCK 1, INDIAN HILLS,
VILLAGE OF FONTANA-ON-GENEVA LAKE,
WALWORTH COUNTY, WISCONSIN.


ORDERED BY: DR. JOHN P. MCPHERSON
1803 OLD ORCHARD
ROCKFORD, IL 61100

I, HAROLD H. KOLB, DO HEREBY CERTIFY THAT I HAVE
SURVEYED THE PROPERTY HEREON DESCRIBED ACCORDING
TO THE OFFICIAL RECORDS, AND THAT THE PLAT HEREON
IS A CORRECT REPRESENTATION OF THE LOT LINES.

Harold H. Kolb

HAROLD H. KOLB
WISCONSIN REGISTERED LAND SURVEYOR, S-187

DATE: Oct. 3, 1978

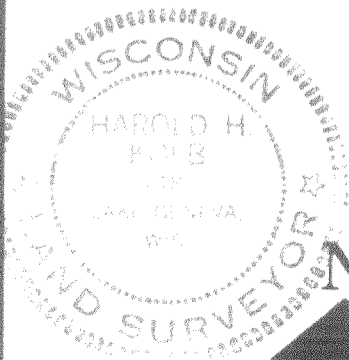

SCALE: 1" = 20'
LEGEND

- ⊙ — IRON PIPE FOUND
- — CONCRETE MONUMENT, 5" DIA. x 30"
- () — AS PLATTED