




SCALE ~ 1" = 40'
 ● = CONC. MONU.
 ○ = IRON PIPE.

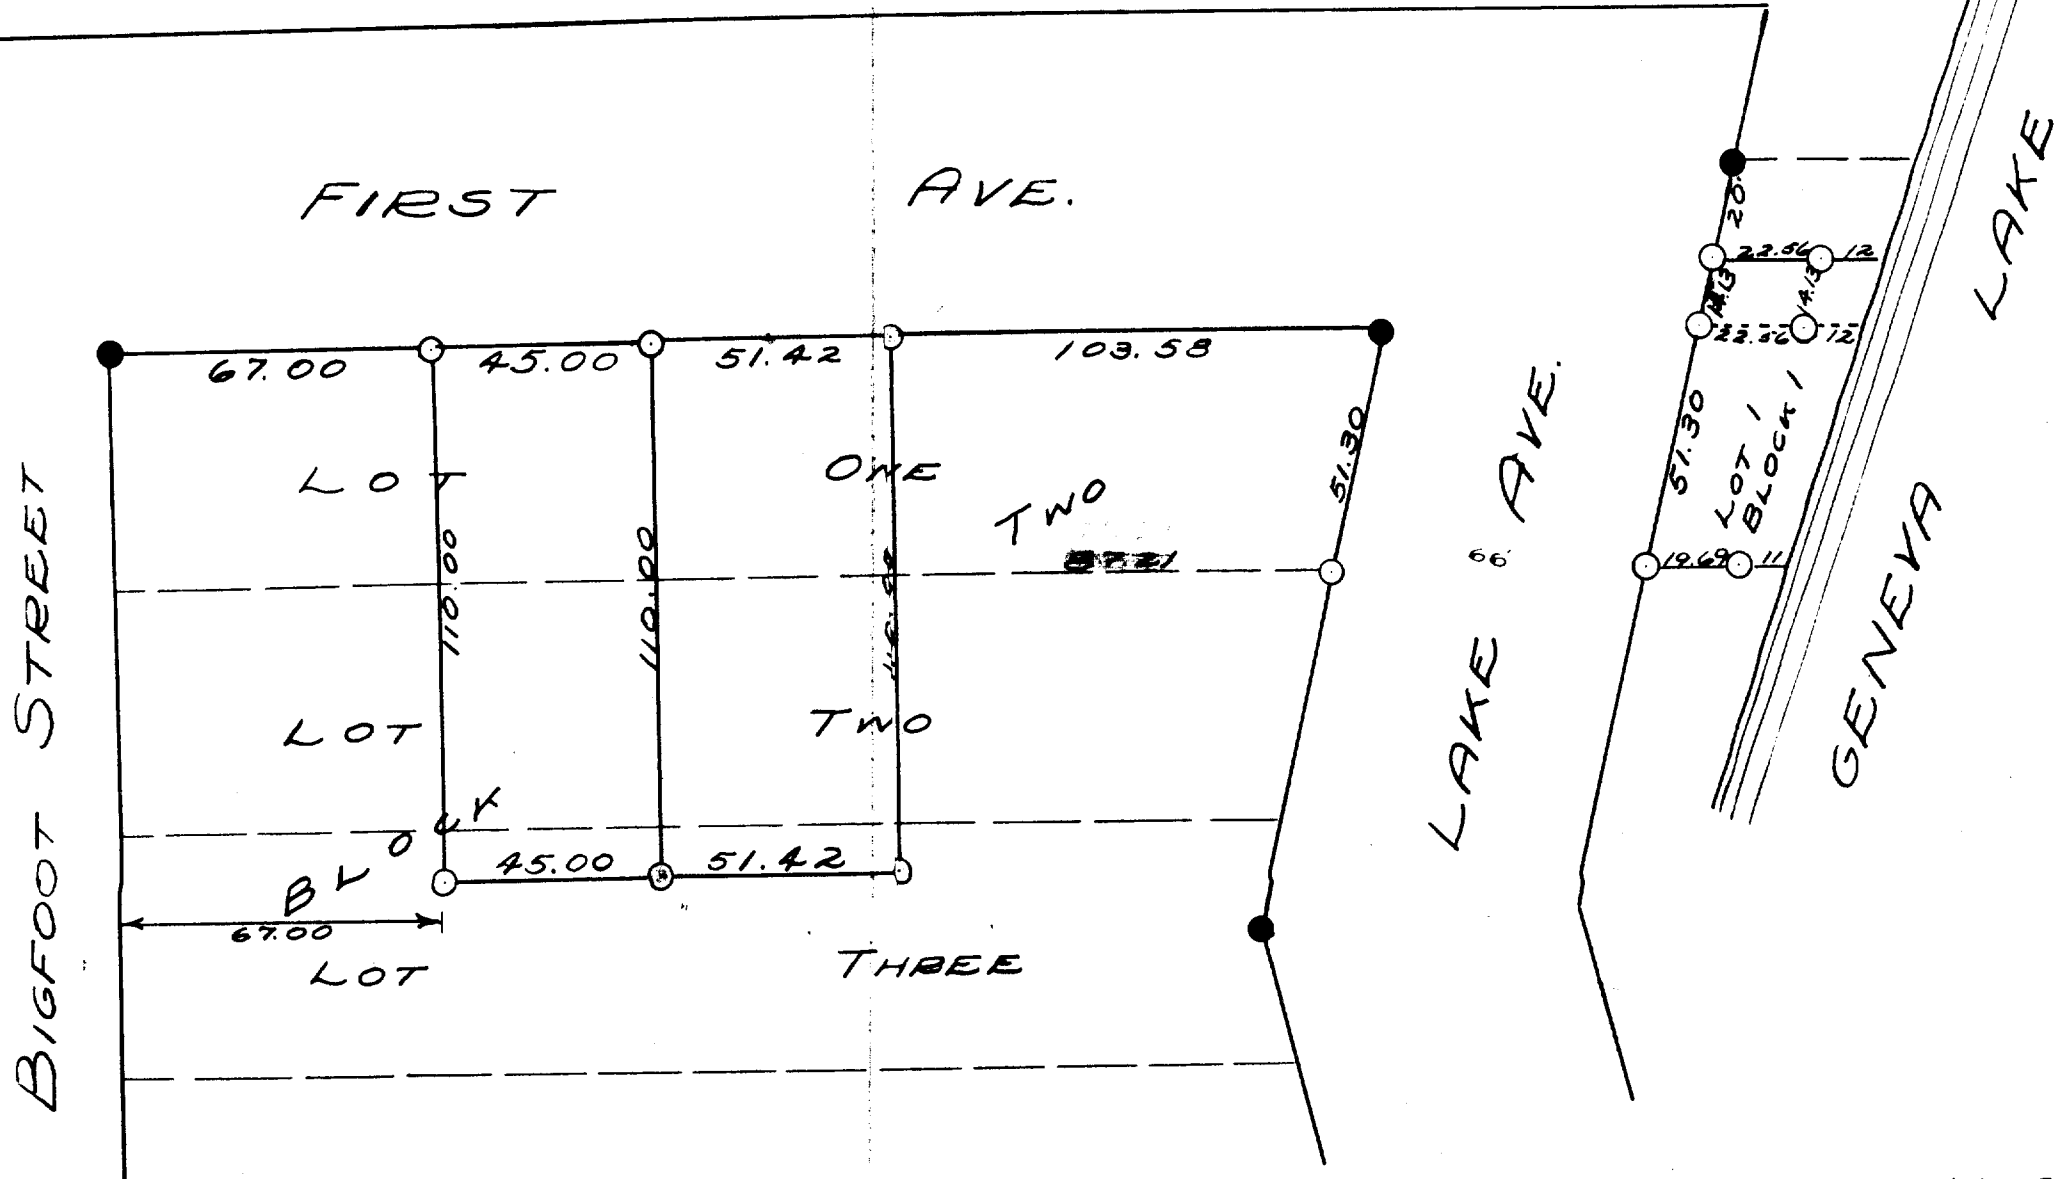

PLAT OF SURVEY OF PART OF LOT 1, BLOCK 1 & PART OF LOTS 1, 2, & 3 OF BLOCK 2 OF D.A. REID'S ADDITION TO REID'S PARK, IN THE VILLAGE OF FONTANA-ON-GENEVA-LAKE, WALWORTH COUNTY, WISCONSIN.

MARCH, 1940

Lloyd Jensen
 COUNTY SURVEYOR