

COOPER SURVEYING SERVICES



Rural - Residential - Commercial

Route 3, Box 255 :: Elkhorn, Wisconsin 53121

Phone (414) 723-6265

SURVEYING & PLANNING
SUBDIVISIONS - LOT SURVEYS
CONSTRUCTION STAKING - MAPPING

PLAT OF SURVEY OF LOT J 16 OF COUNTRY CLUB ESTATES ADDITION J
TO THE VILLAGE OF FONTANA-ON- GENEVA LAKE WALNORTH COUNTY WIS.

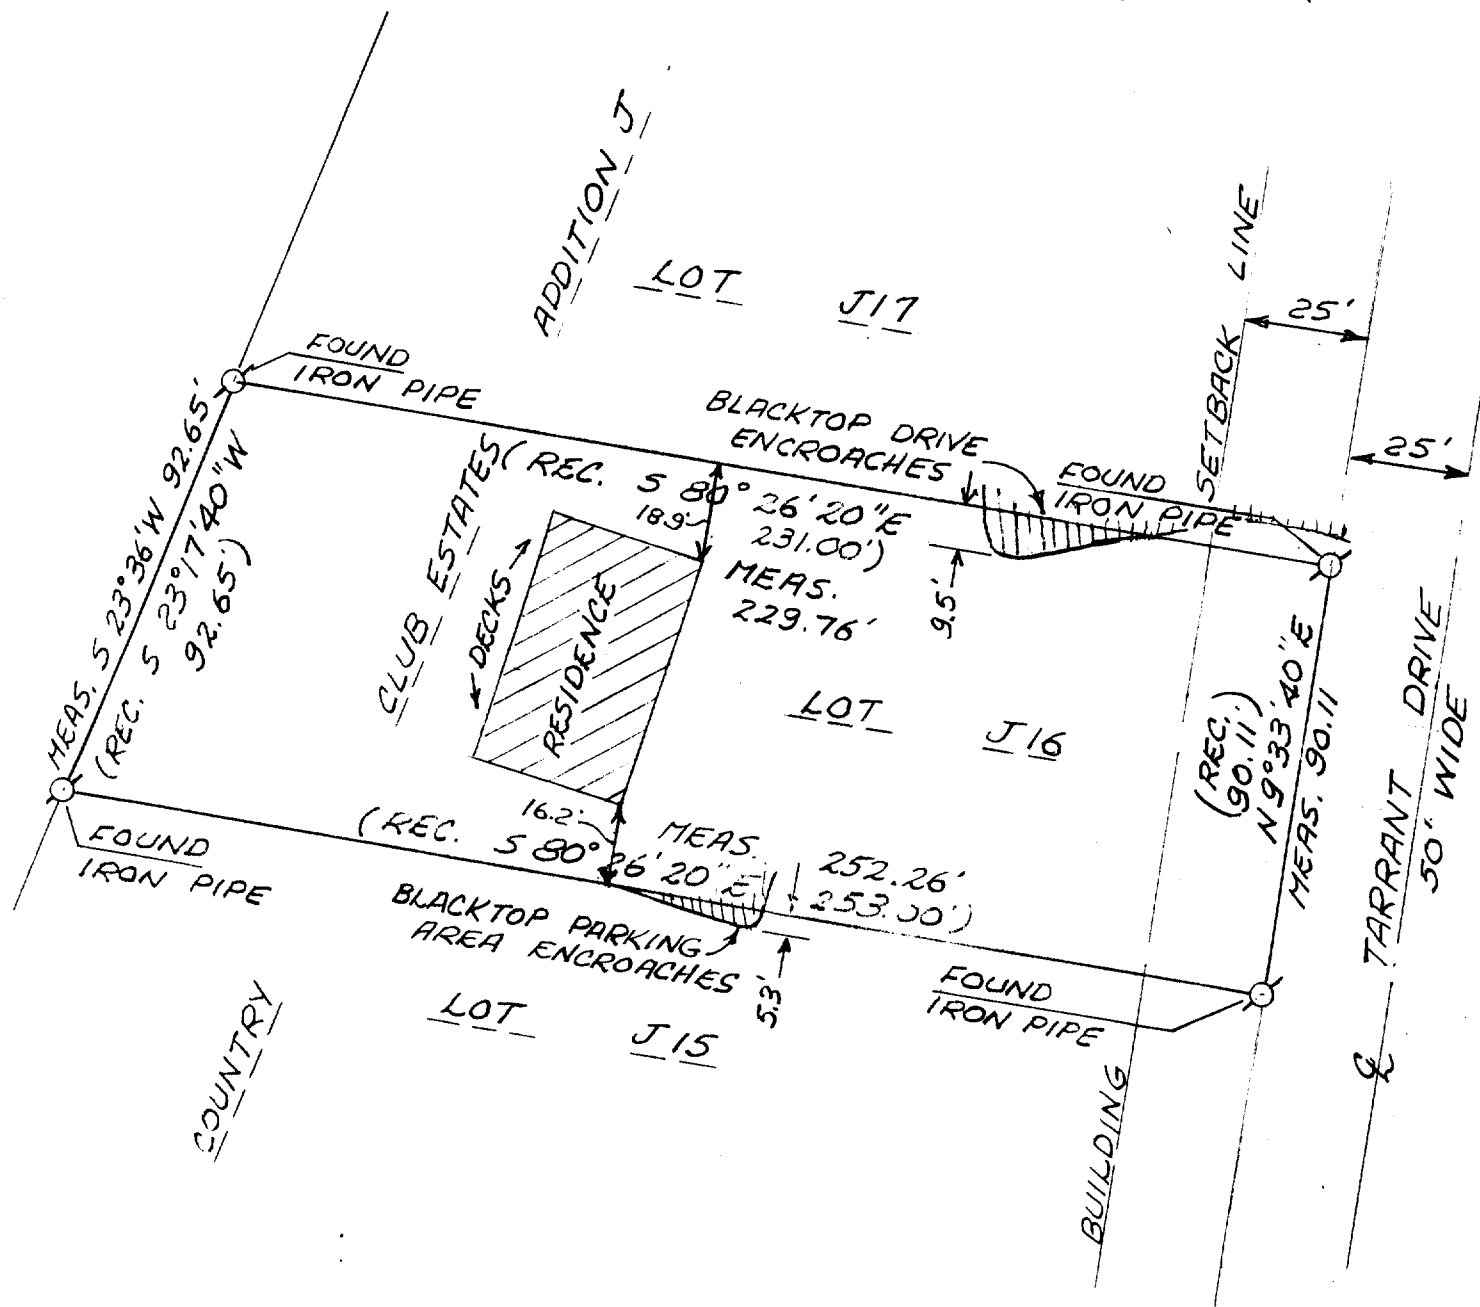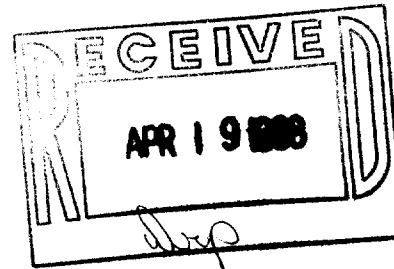


SURVEY DONE FOR: KEEFE REALTY

I, DANIEL D. COOPER, REGISTERED SURVEYOR, DO HEREBY CERTIFY THAT
I HAVE SURVEYED THE PROPERTY DESCRIBED HEREON AND THAT THE MAP
SHOWN HEREON IS A TRUE AND ACCURATE REPRESENTATION THEROF TO THE
BEST OF MY PROFESSIONAL KNOWLEDGE AND BELIEF.

DATED THIS 5th DAY OF June, 1984

[Signature]
DANIEL D. COOPER, RLS NO. S-1464

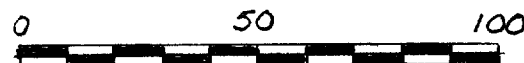

SCALE: 1"=40'

DRAWING NO. 1924