


DUNHAM SURVEYING, S.C.  
SURVEYING & SUBDIVIDING  
DELAVAL, WISCONSIN 53115

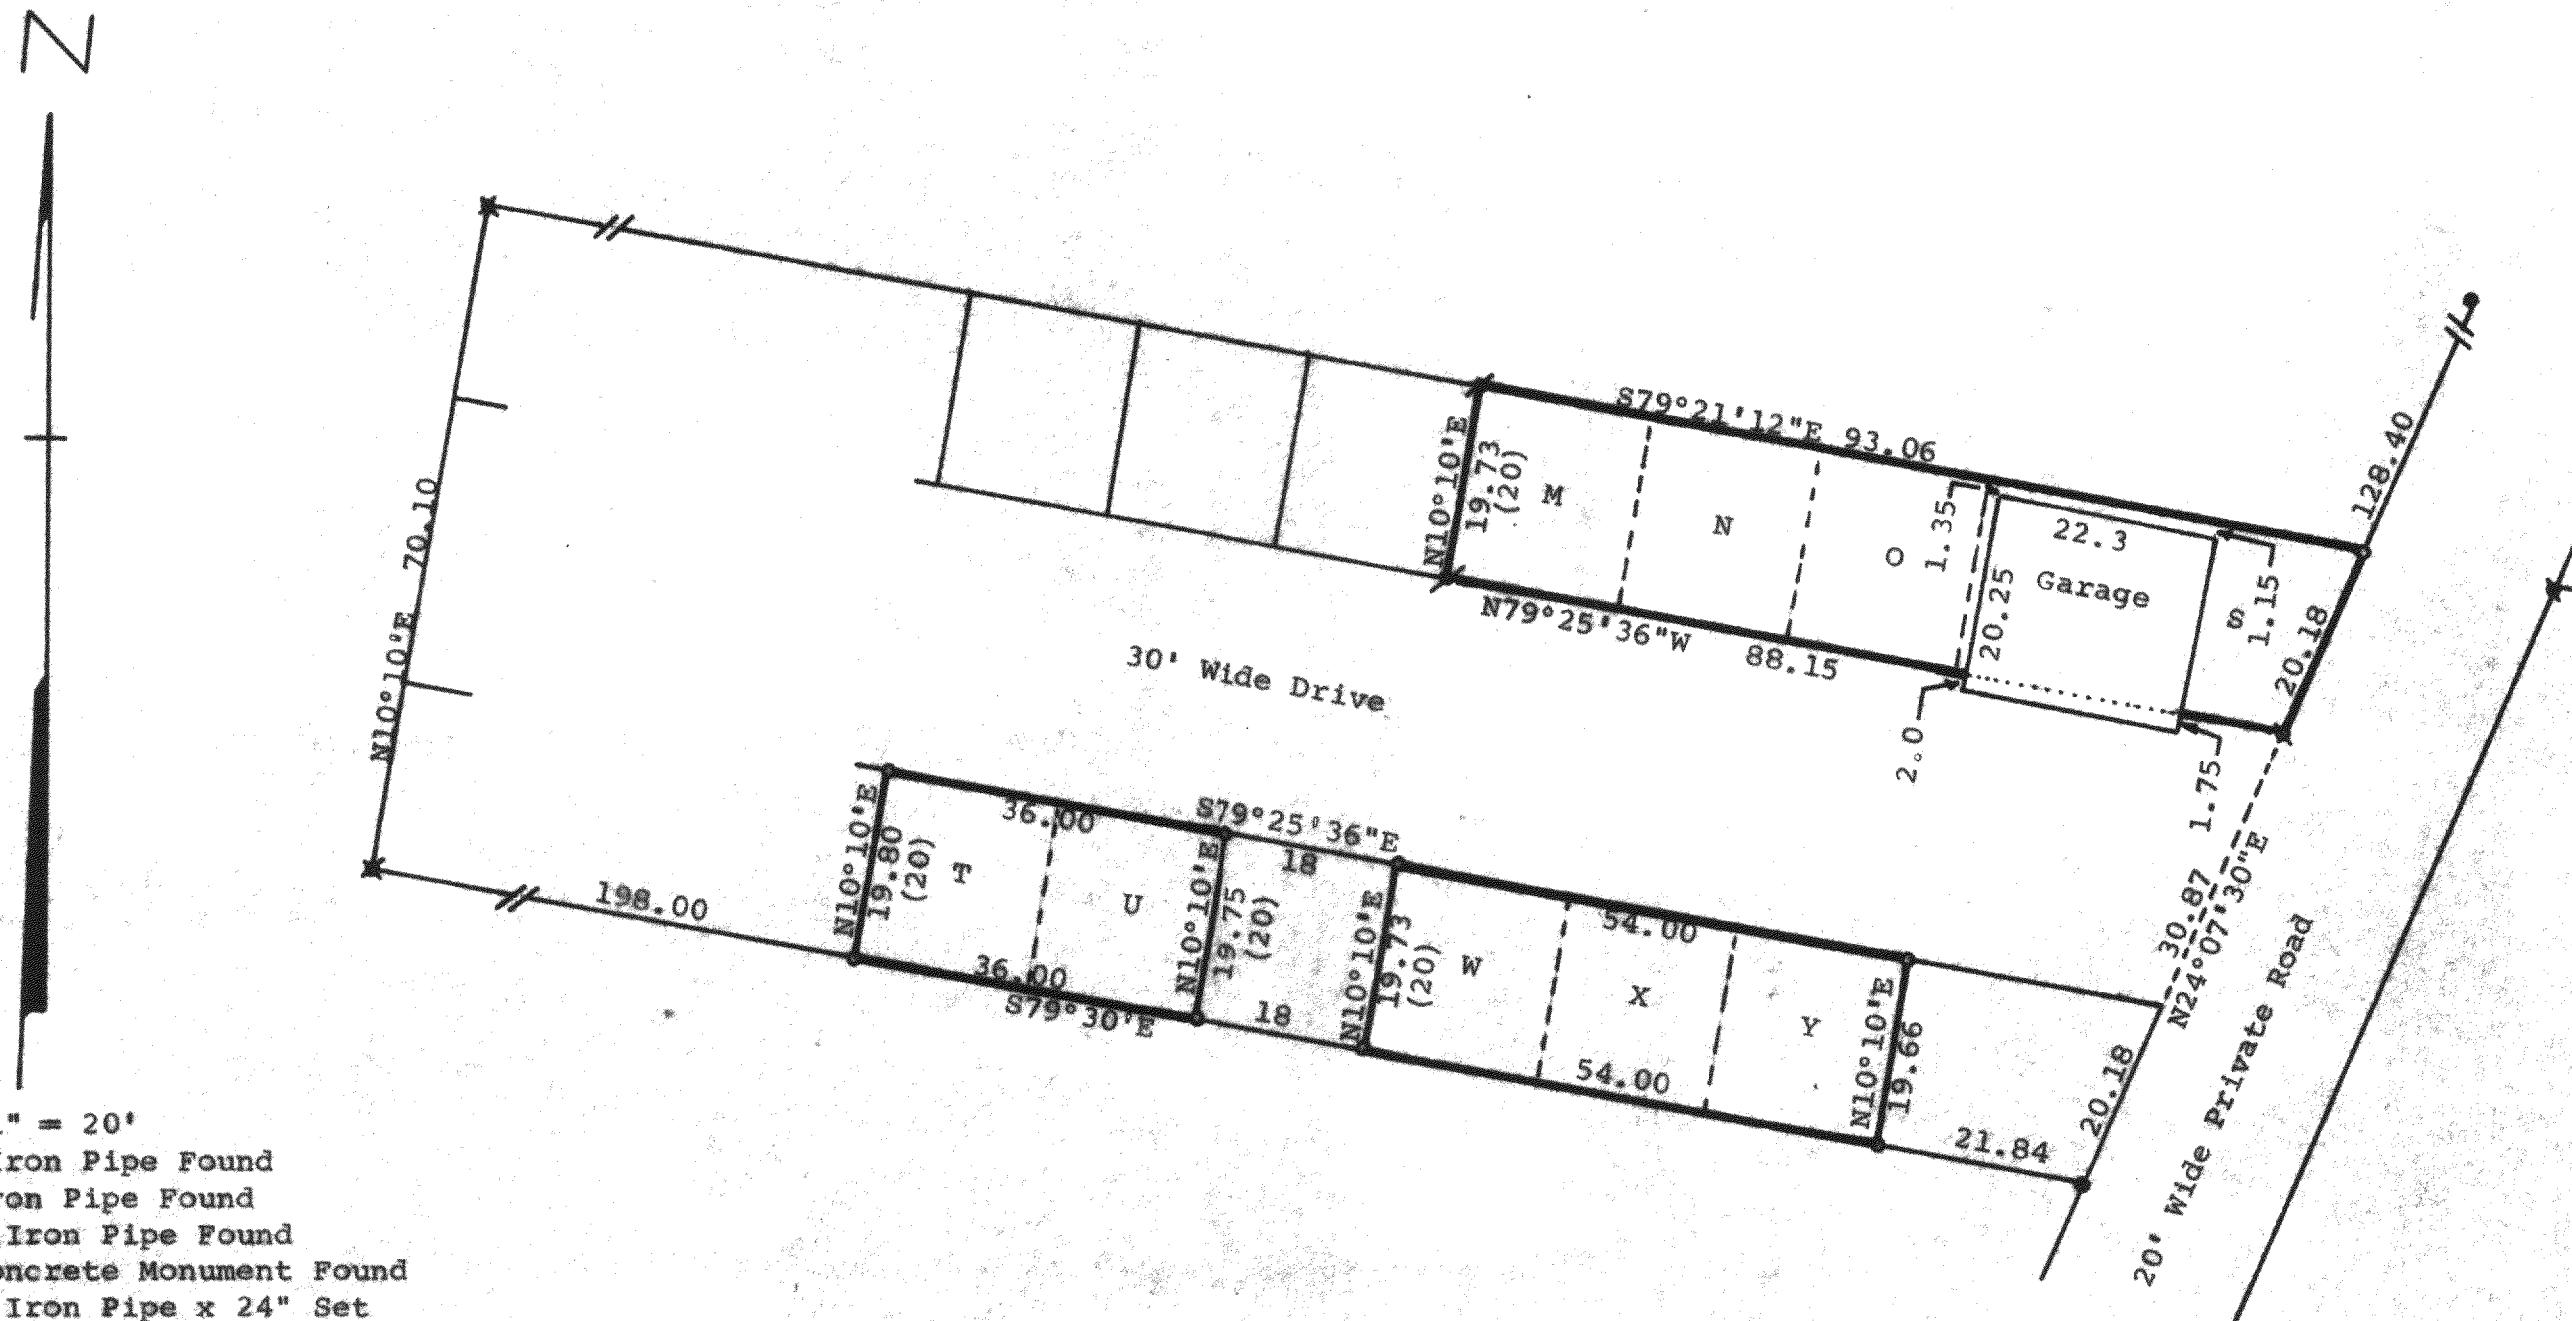

Scale - 1" = 20'

■ = 1 $\frac{1}{4}$ " Iron Pipe Found  
 ▲ = 1" Iron Pipe Found  
 △ = 3/4" Iron Pipe Found  
 ● = 5" Concrete Monument Found  
 ○ = 3/4" Iron Pipe x 24" Set  
 ▨ = 1/2" X 24" Iron Pipe Set

(0.00) = recorded distance  
Owner: Isabella MacPherson Estate  
c/o Arnold & Arnold  
9 West Walworth

Elkhorn, WI 53121

Bearings referenced to the recorded bearing of S79°30'E along the southerly line of the garage lots.

STATE OF WISCONSIN) SS  
COUNTY OF WALWORTH)

I, George T. Dunham, Surveyor, certify that I have surveyed the property described as follows:

Garage Lots W, X, M, N, O, S, T, U, and V of The Gardens Subdivision No. 2 located in the Village of Fontana-on-Geneva Lake, Walworth County, Wisconsin, and that the plat shown above is a true representation thereof and shows the size and location of the property, its exterior boundaries, the location of all visible structures and dimensions of all principal buildings thereon, boundary fences, apparent easements, roadways and visible encroachments, if any, and that I have surveyed the property herein described according to the official records to the best of my knowledge and belief.

May 14, 1984

*George T. Dunham*  
George T. Dunham, Surveyor

