

RECEIVED
JUL 30 1985

WALWORTH COUNTY
SURVEYING & MAPPING
LAKE GENEVA, WISCONSIN

LEGEND

- ⊗ - IRON PIPE FOUND
- - IRON ROD PLACED
- () - RECORDED AS

PLAT OF SURVEY OF

LOTS 4, 5, AND 6, BLOCK 5 OF INDIAN HILLS
1ST ADDITION, LOCATED IN SECTION 14, T 1 N,
R 16 E, VILLAGE OF FONTANA, WALWORTH
COUNTY, WISCONSIN.

ORDERED BY: KAIP-LLOYD
205 E. GRAND AVENUE
CHICAGO, ILLINOIS

SANITARY SEWER

SHOSHONI ROAD

CENTERLINE AS TRAVELLED

20' WIDE

UTILITY POLE


GRAVEL
PARKING
AREA

B L O C K

GAS LINE

DECK

RESIDENCE

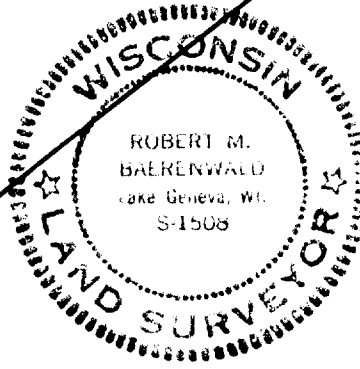

I, ROBERT M. BAERENWALD, DO HEREBY
CERTIFY THAT I HAVE SURVEYED THE PROPERTY
HEREON DESCRIBED ACCORDING TO THE OFFICIAL
RECORDS AND THAT THE PLAT HEREON IS A CORRECT
REPRESENTATION OF THE PROPERTY LINES TO THE BEST
OF MY KNOWLEDGE AND BELIEF.

Robert M. Baerenwald
ROBERT M. BAERENWALD
WISCONSIN REGISTERED LAND SURVEYOR, S-1508

DATE *July 27, 1984*

JOB NO. 0086



SCALE: 1"=20'