

DUNHAM SURVEYING, S. C. SURVEYING & SUBDIVIDING DELAVAN, WISCONSIN 53115

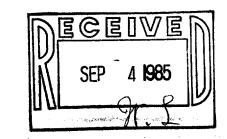

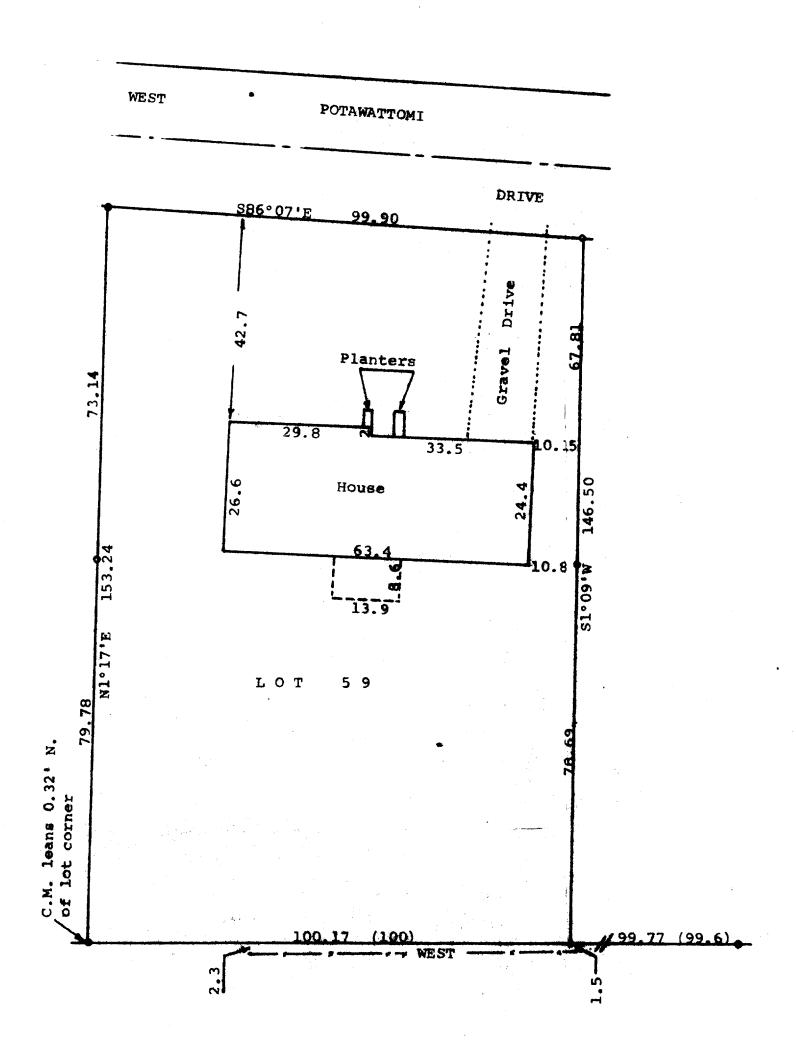

Scale - 1" = 20'

• = Concrete Monument Found •= 3/4" X 24" Iron Pipe Set -- Fence Line Bearings reference to the south line of Lot 59 With the Assumed Bearing of West Survey ordered by Churchill Real Estate 322 Park Walworth, WI 53184

STATE OF WISCONSIN) SS COUNTY OF WALWORTH)

I, George T. Dunham, Surveyor, certify that I have surveyed the property described as follows:

Lot 59 in Unit No. 2 of Country Club Estates, located in the Village of Fontana on Geneva Lake, Walworth County, Wisconsin, and that the map shown hereon is a correct representation thereof and shows the size and location of the property, its exterior boundaries, the location of all visible structures and dimensions of all principal buildings thereon, boundary fences, apparent easements, roadways and visible encroachments, if any, and that I have surveyed the property hereon described according to the official records to the best of my knowledge and belief. June 18, 1985

George T. Dunham, Surveyor

