


RECEIVED
 SEP 30 1985
H.S.

HAROLD H. KOLB
 REGISTERED PROFESSIONAL LAND SURVEYOR
 LAKE GENEVA, WISCONSIN

ORDERED BY:
 BOB KEEFE & ASSOCIATES

REVISION ORDERED BY:
 FIRST BANK SOUTHEAST
 303 CENTER STREET
 LAKE GENEVA, WI. LOT 4
 53147

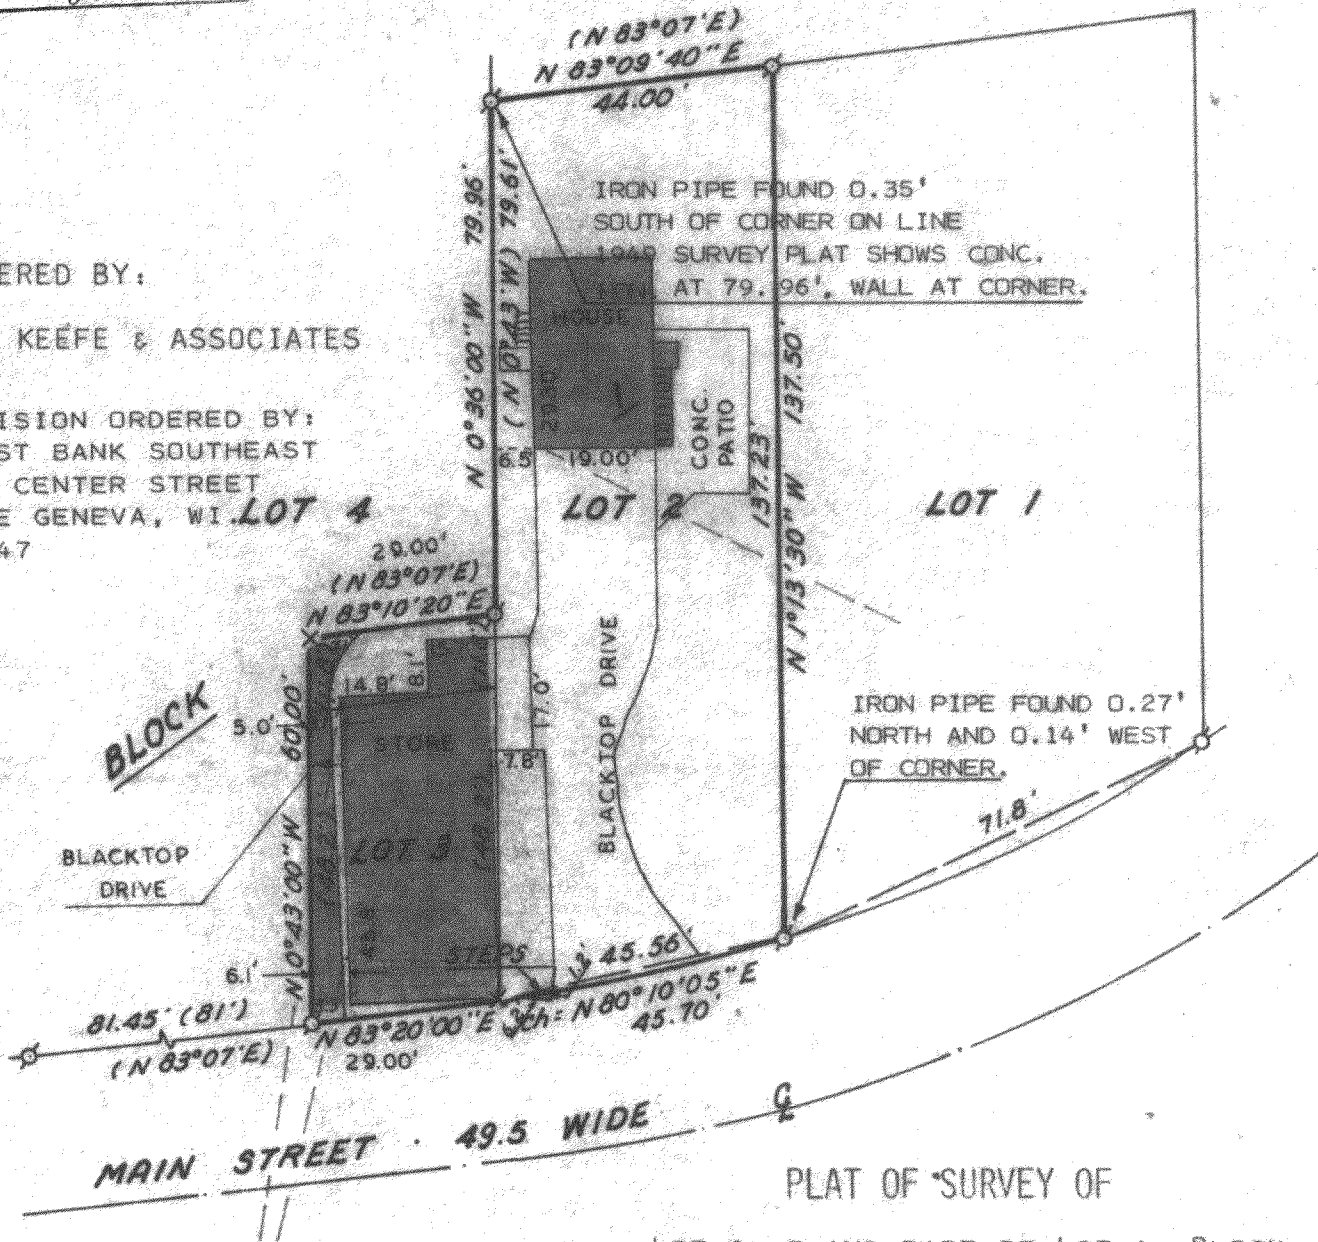


PLAT OF SURVEY OF

LOT 2, 3 AND PART OF LOT 4, BLOCK 1, C. L. DOUGLAS SUBDIVISION, VILLAGE OF FONTANA-ON-GENEVA LAKE, WALWORTH COUNTY, WISCONSIN.

NOTE: THE WEST LINE OF LOT 3 IS ASSUMED N 0°43' W AS SHOWN ON EXISTING RECORDS.

ACCURACY: DISTANCES ± 0.01'
 ANGLES ± 05"
 ERROR OF CLOSURE--LESS THAN ONE PART IN 3000

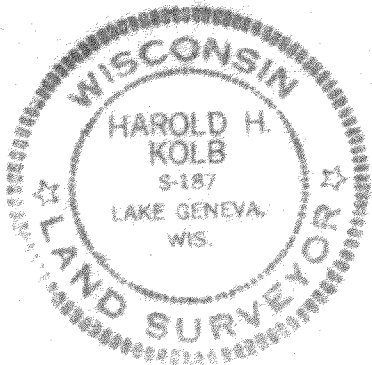

N

SCALE: 1"=30'

LEGEND

- - IRON PIPE PLACED () - AS RECORDED
- - CONCRETE MONUMENT X - RAILROAD SPIKE
- ⊕ - IRON PIPE FOUND — — — OVER HEAD UTILITY LINE

Harold H. Kolb
 HAROLD H. KOLB
 WISCONSIN REGISTERED LAND SURVEYOR, S-187
 DATE Dec. 29, 1976

5-628-K