


● = Iron Pipe

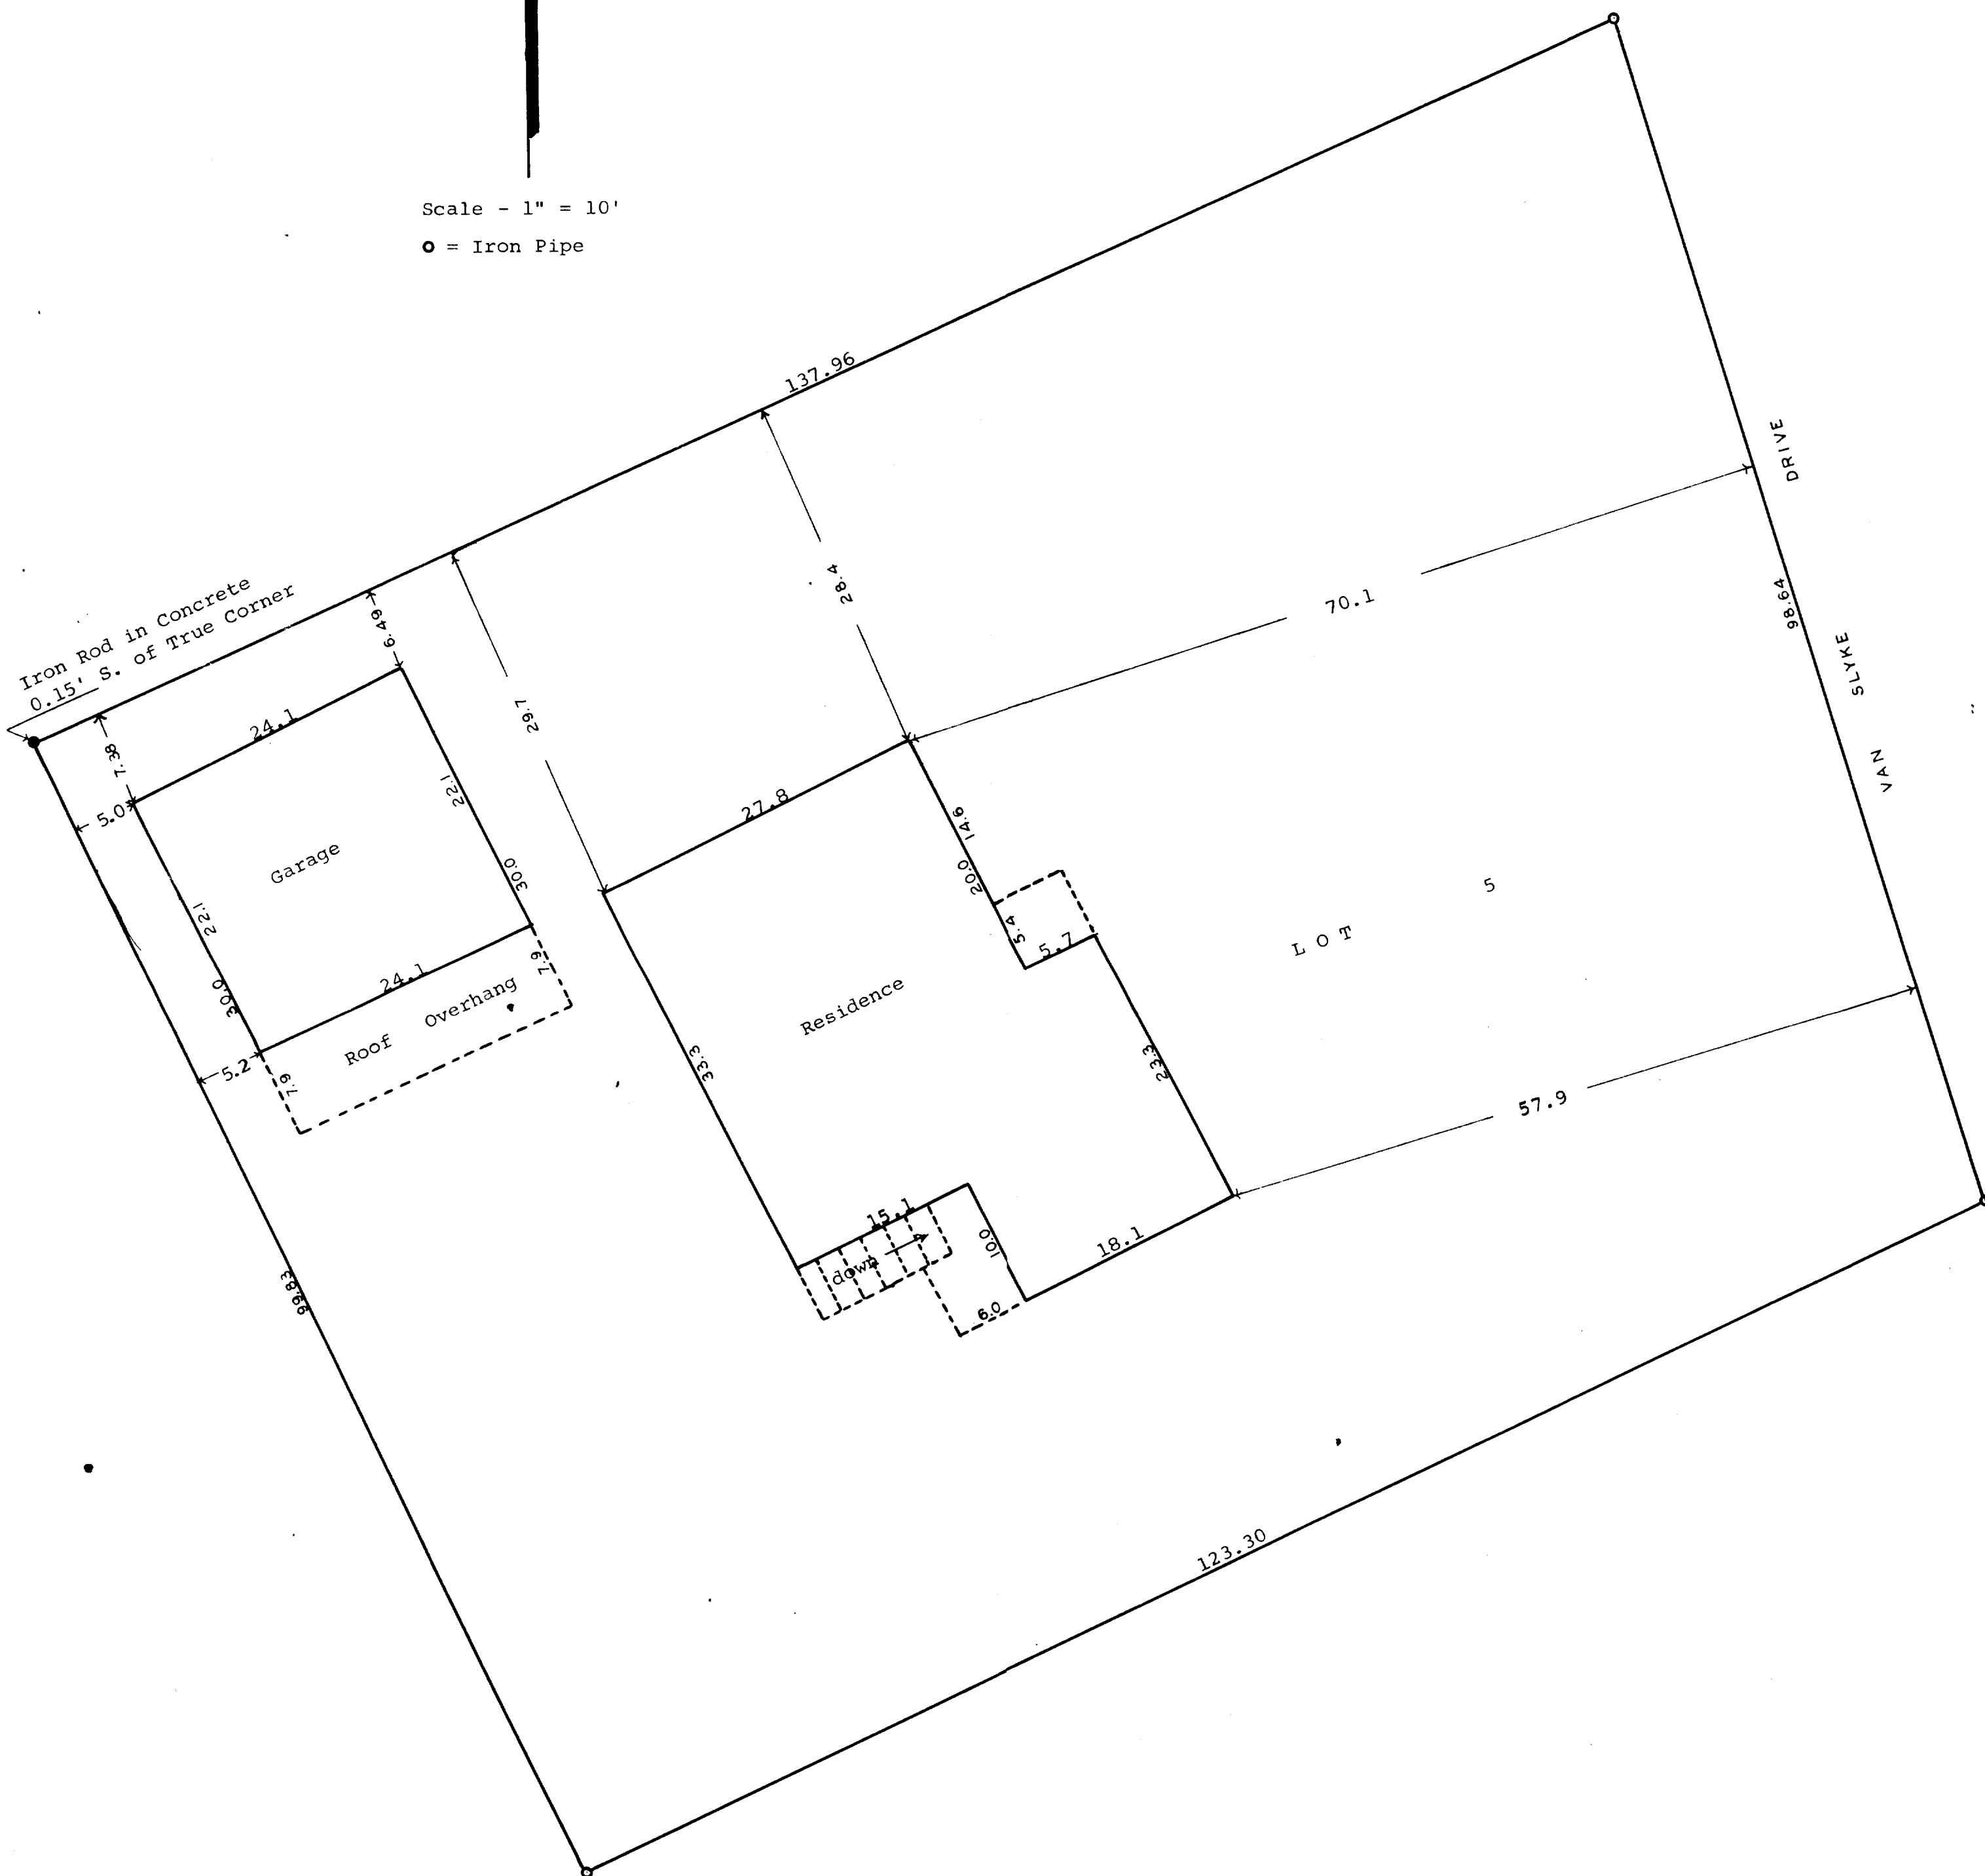

July 3, 1964

5C03-57