


GEORGE T. DUNHAM
SURVEYING & SUBDIVIDING
DELAVAN, WISCONSIN

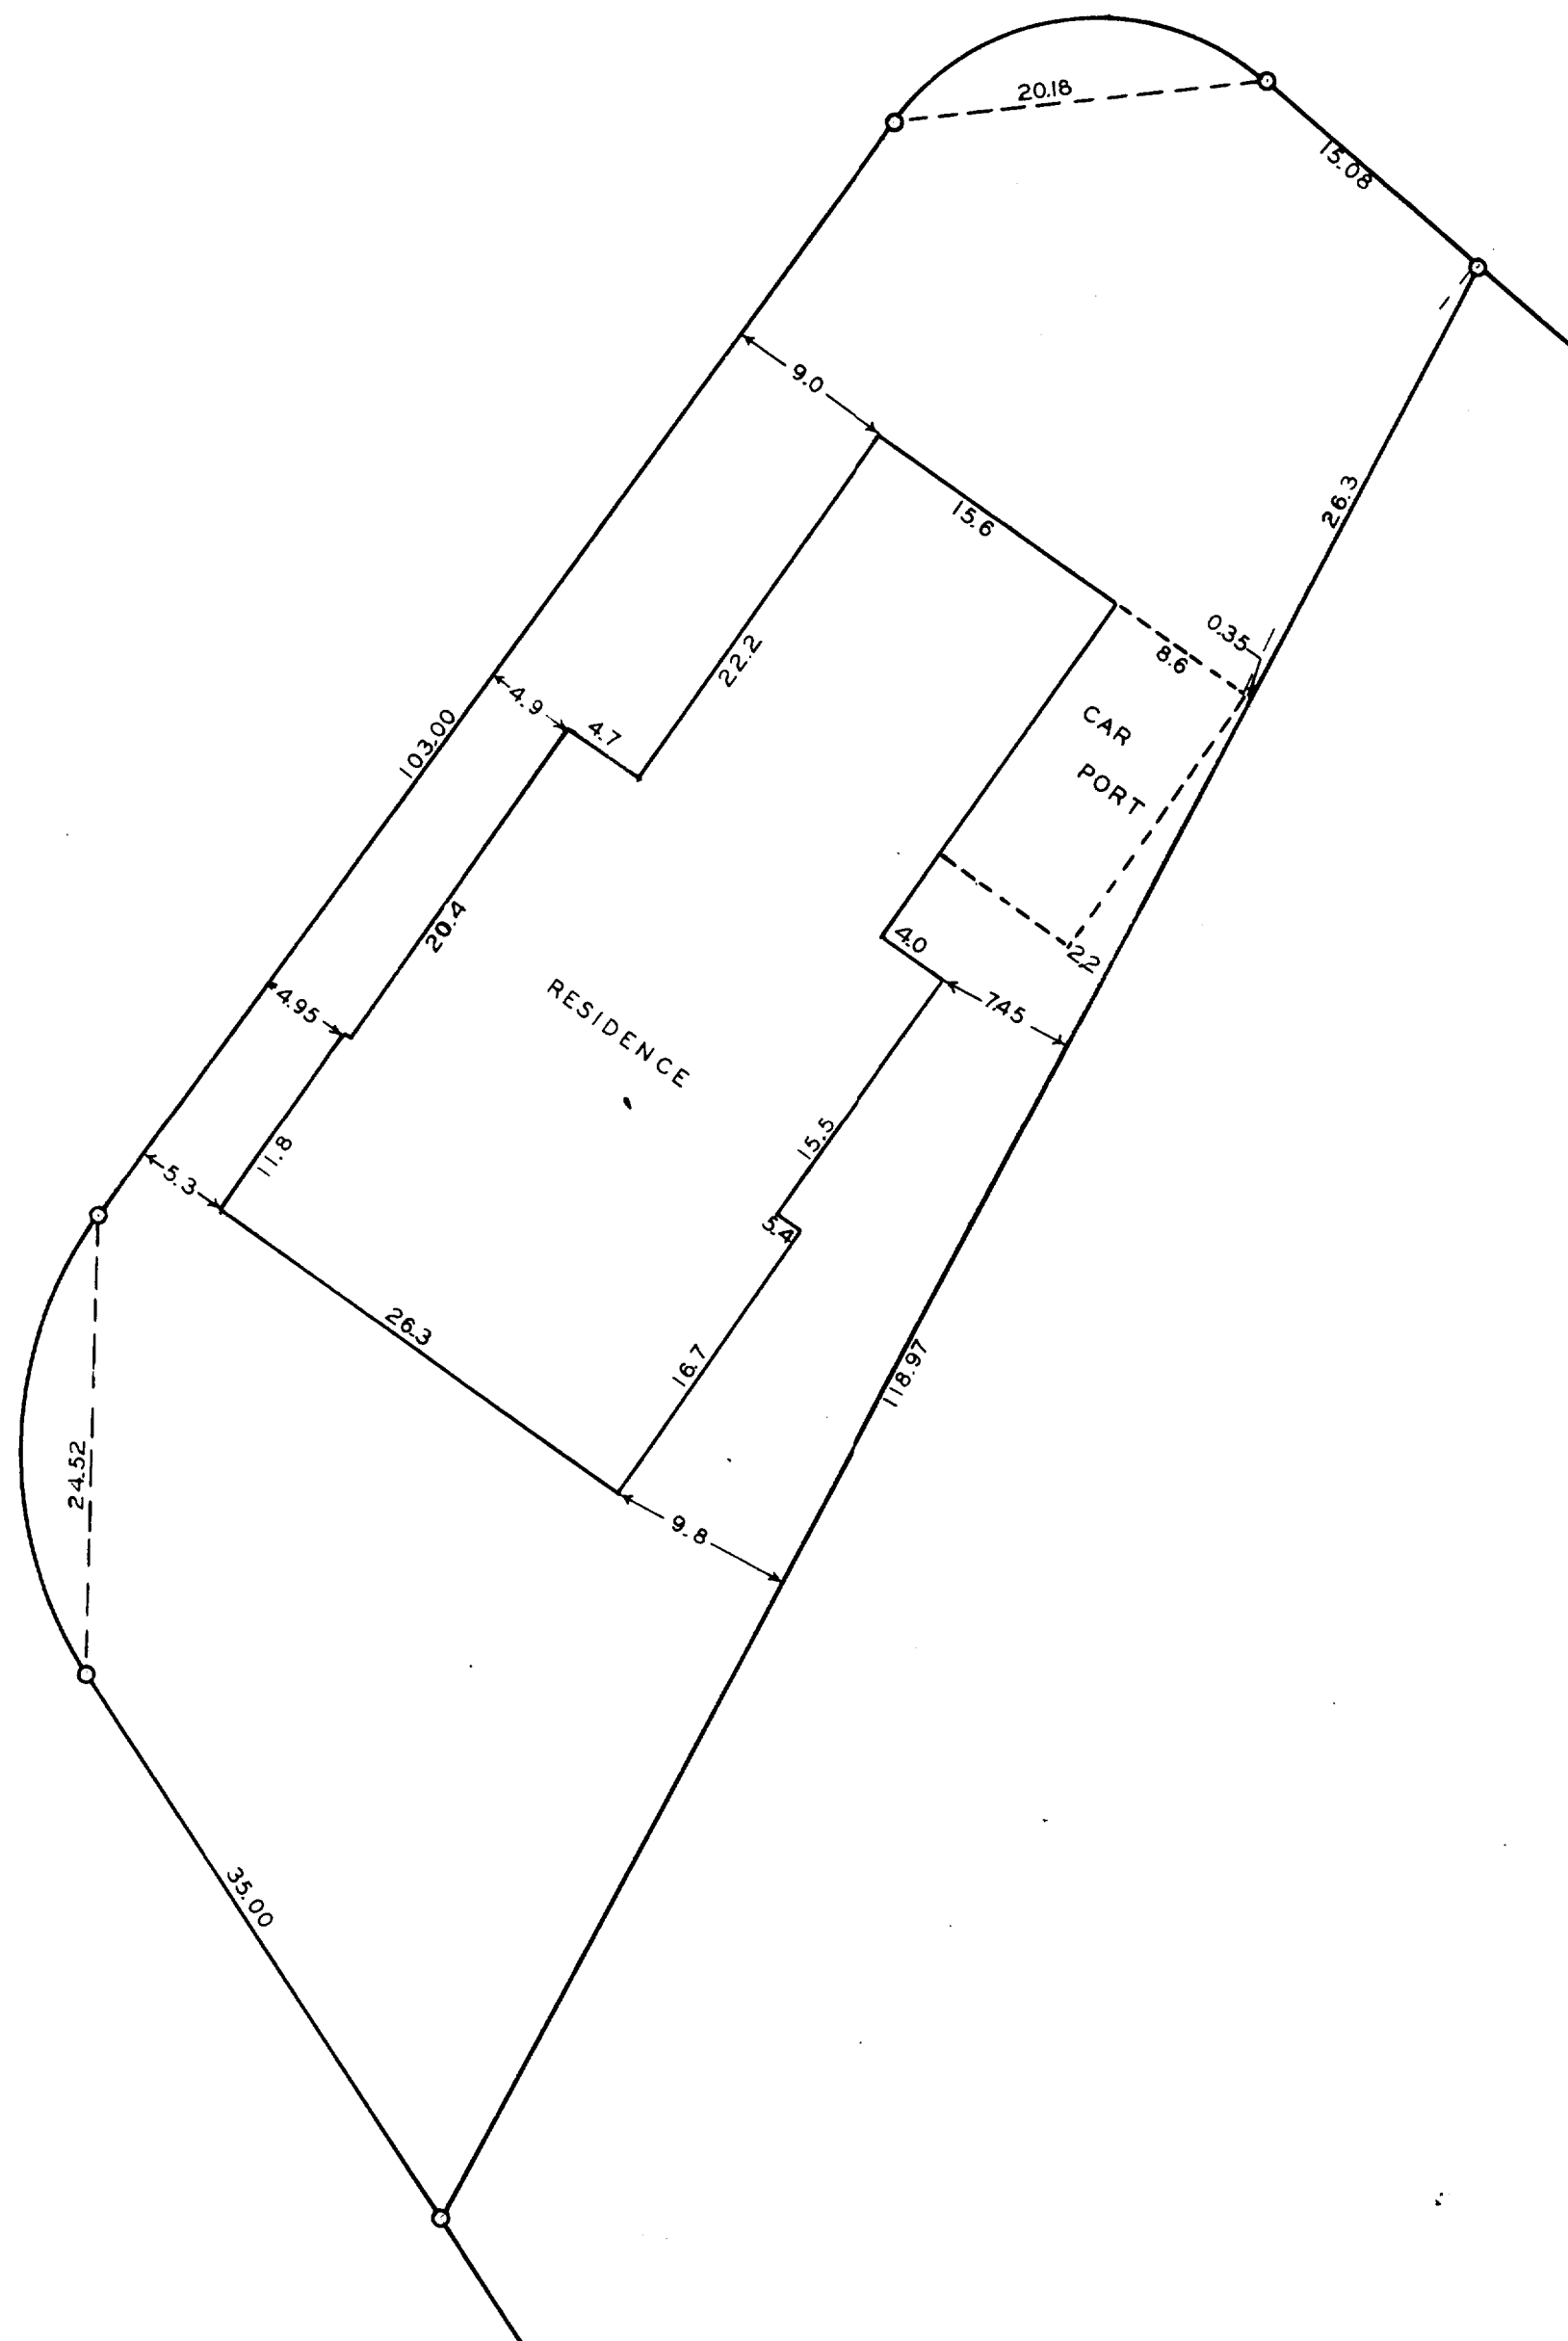

Scale - 1" = 10'
O = Iron Pipe

Plat of survey of Lot 20 in Buena Vista located in the
Village of Fontana on Geneva Lake, Walworth County,
Wisconsin
September 12, 1963

George T. Dunham
George T. Dunham, Surveyor