
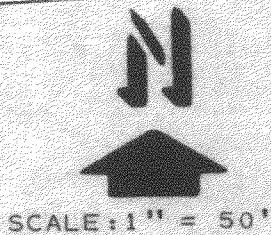


KOLB LAND CONSULTING, INC.
LAND SURVEYING • SUBDIVIDING • LAND PLANNING

929 WILLIAMS STREET

LAKE GENEVA, WISCONSIN 53147

414-248-3697

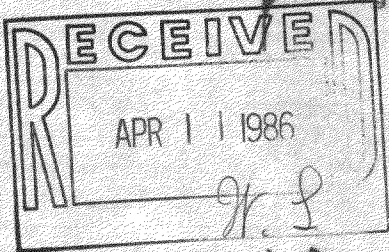

SCALE: 1" = 50'


LEGEND

- o - IRON PIPE FOUND
- o - 1 1/4" X 24" IRON PIPE SET
- x - RAILROAD SPIKE SET
- () - AS RECORDED

ORDERED BY: KENT SHODEEN
13 S. 7TH STREET
GENEVA, IL. 60134

FOUND IRON PIPE
0.36'S. & 0.58'W.
OF CORNER

PLAT OF SURVEY OF

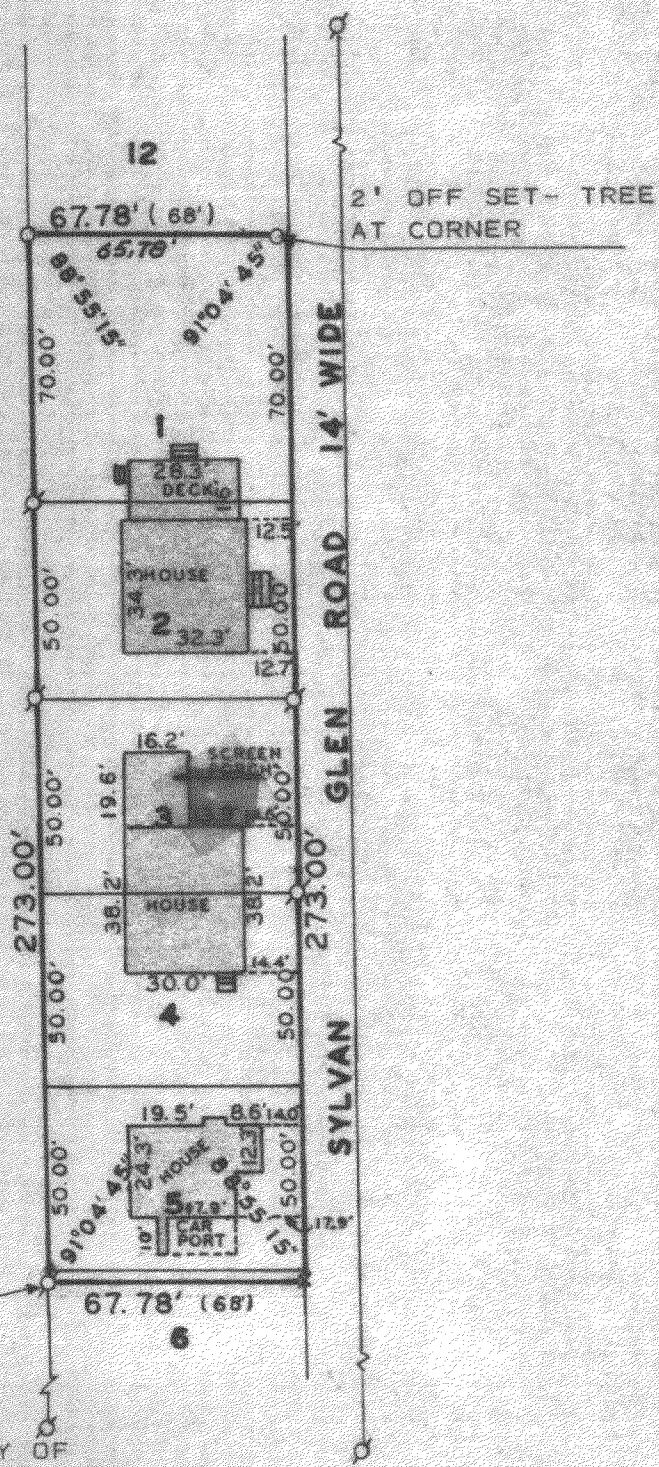


LOTS 1-5 AND THE NORTH THREE (3) FEET OF LOT 6, SYLVAN GLEN SUB-DIVISION, VILLAGE OF FONTANA-ON-GENEVA LAKE, WALWORTH COUNTY WISCONSIN.

I, HAROLD H. KOLB, DO HEREBY CERTIFY THAT I HAVE SURVEYED THE PROPERTY HEREON DESCRIBED ACCORDING TO THE OFFICIAL RECORDS, AND THAT THE PLAT HEREON IS A CORRECT REPRESENTATION OF THE LOT LINES TO THE BEST OF MY KNOWLEDGE AND BELIEF.

Harold H. Kolb

HAROLD H. KOLB
WISCONSIN REGISTERED LAND SURVEYOR, S-187
DATE SEPTEMBER 3, 1985
REVISED OCTOBER 31, 1985
REVISED _____


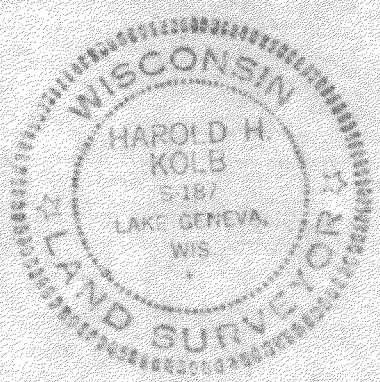


KOLB LAND CONSULTING, INC.
LAND SURVEYING • SUBDIVIDING • LAND PLANNING

929 WILLIAMS STREET

LAKE GENEVA, WISCONSIN 53147

414-248-3697

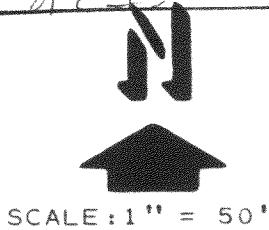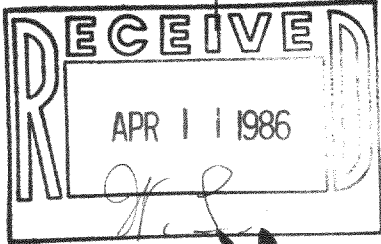

SCALE: 1" = 50'


LEGEND

- Ø - IRON PIPE FOUND
- - 1 1/4" X 24" IRON PIPE SET
- x - RAILROAD SPIKE SET
- () - AS RECORDED

ORDERED BY: KENT SHODEEN
13 S. 7TH STREET
GENEVA, IL. 60134


FOUND IRON PIPE
0.36'S. & 0.58'W.
OF CORNER

PLAT OF SURVEY OF

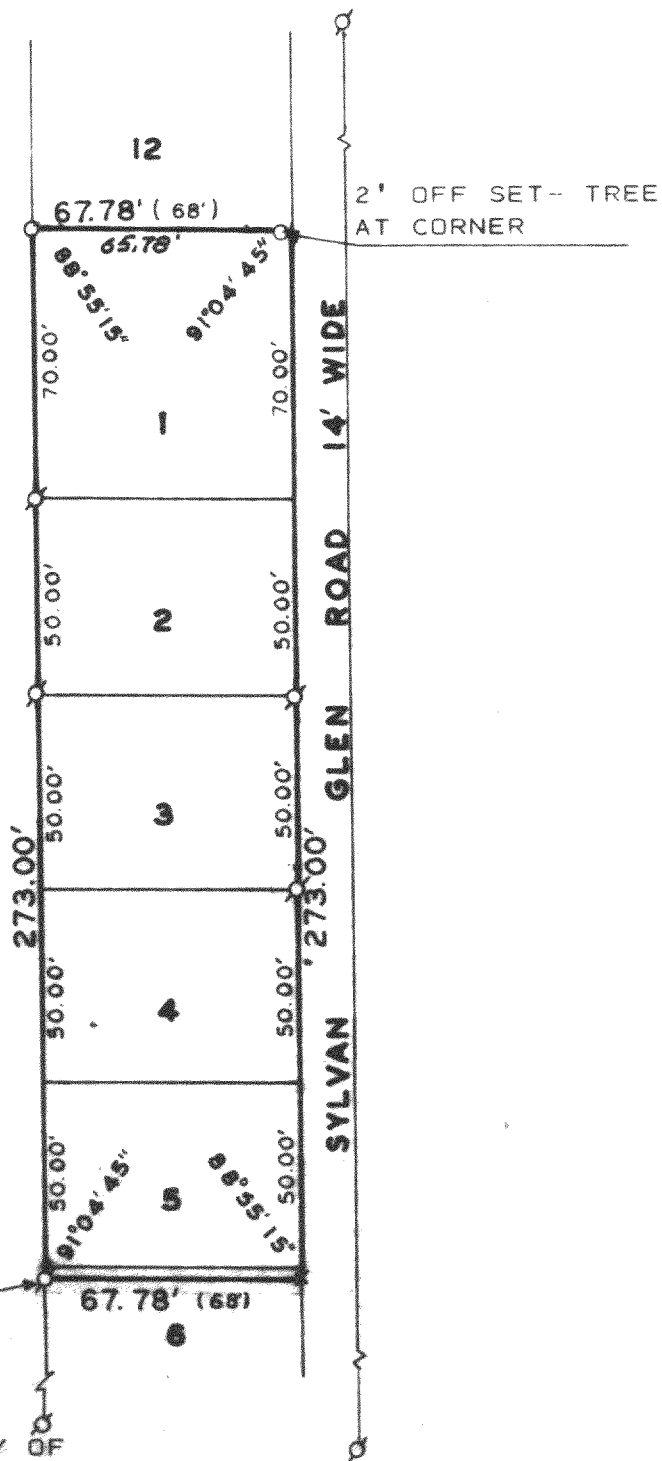

LOTS 1-5 AND THE NORTH THREE (3) FEET OF LOT 6, SYLVAN GLEN SUB-DIVISION, VILLAGE OF FONTANA-ON-GENEVA LAKE, WALWORTH COUNTY WISCONSIN.

I, HAROLD H. KOLB, DO HEREBY CERTIFY THAT
I HAVE SURVEYED THE PROPERTY HEREON DES-
CRIBED ACCORDING TO THE OFFICIAL RECORDS,
AND THAT THE PLAT HEREON IS A CORRECT REP-
RESENTATION OF THE LOT LINES TO THE BEST
OF MY KNOWLEDGE AND BELIEF.

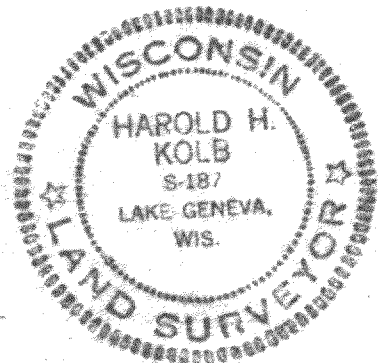

Harold H. Kolb

HAROLD H. KOLB

WISCONSIN REGISTERED LAND SURVEYOR, S-187

DATE SEPTEMBER 3, 1985

REVISED _____

REVISED _____

F-556N-1-4 5-640-K