
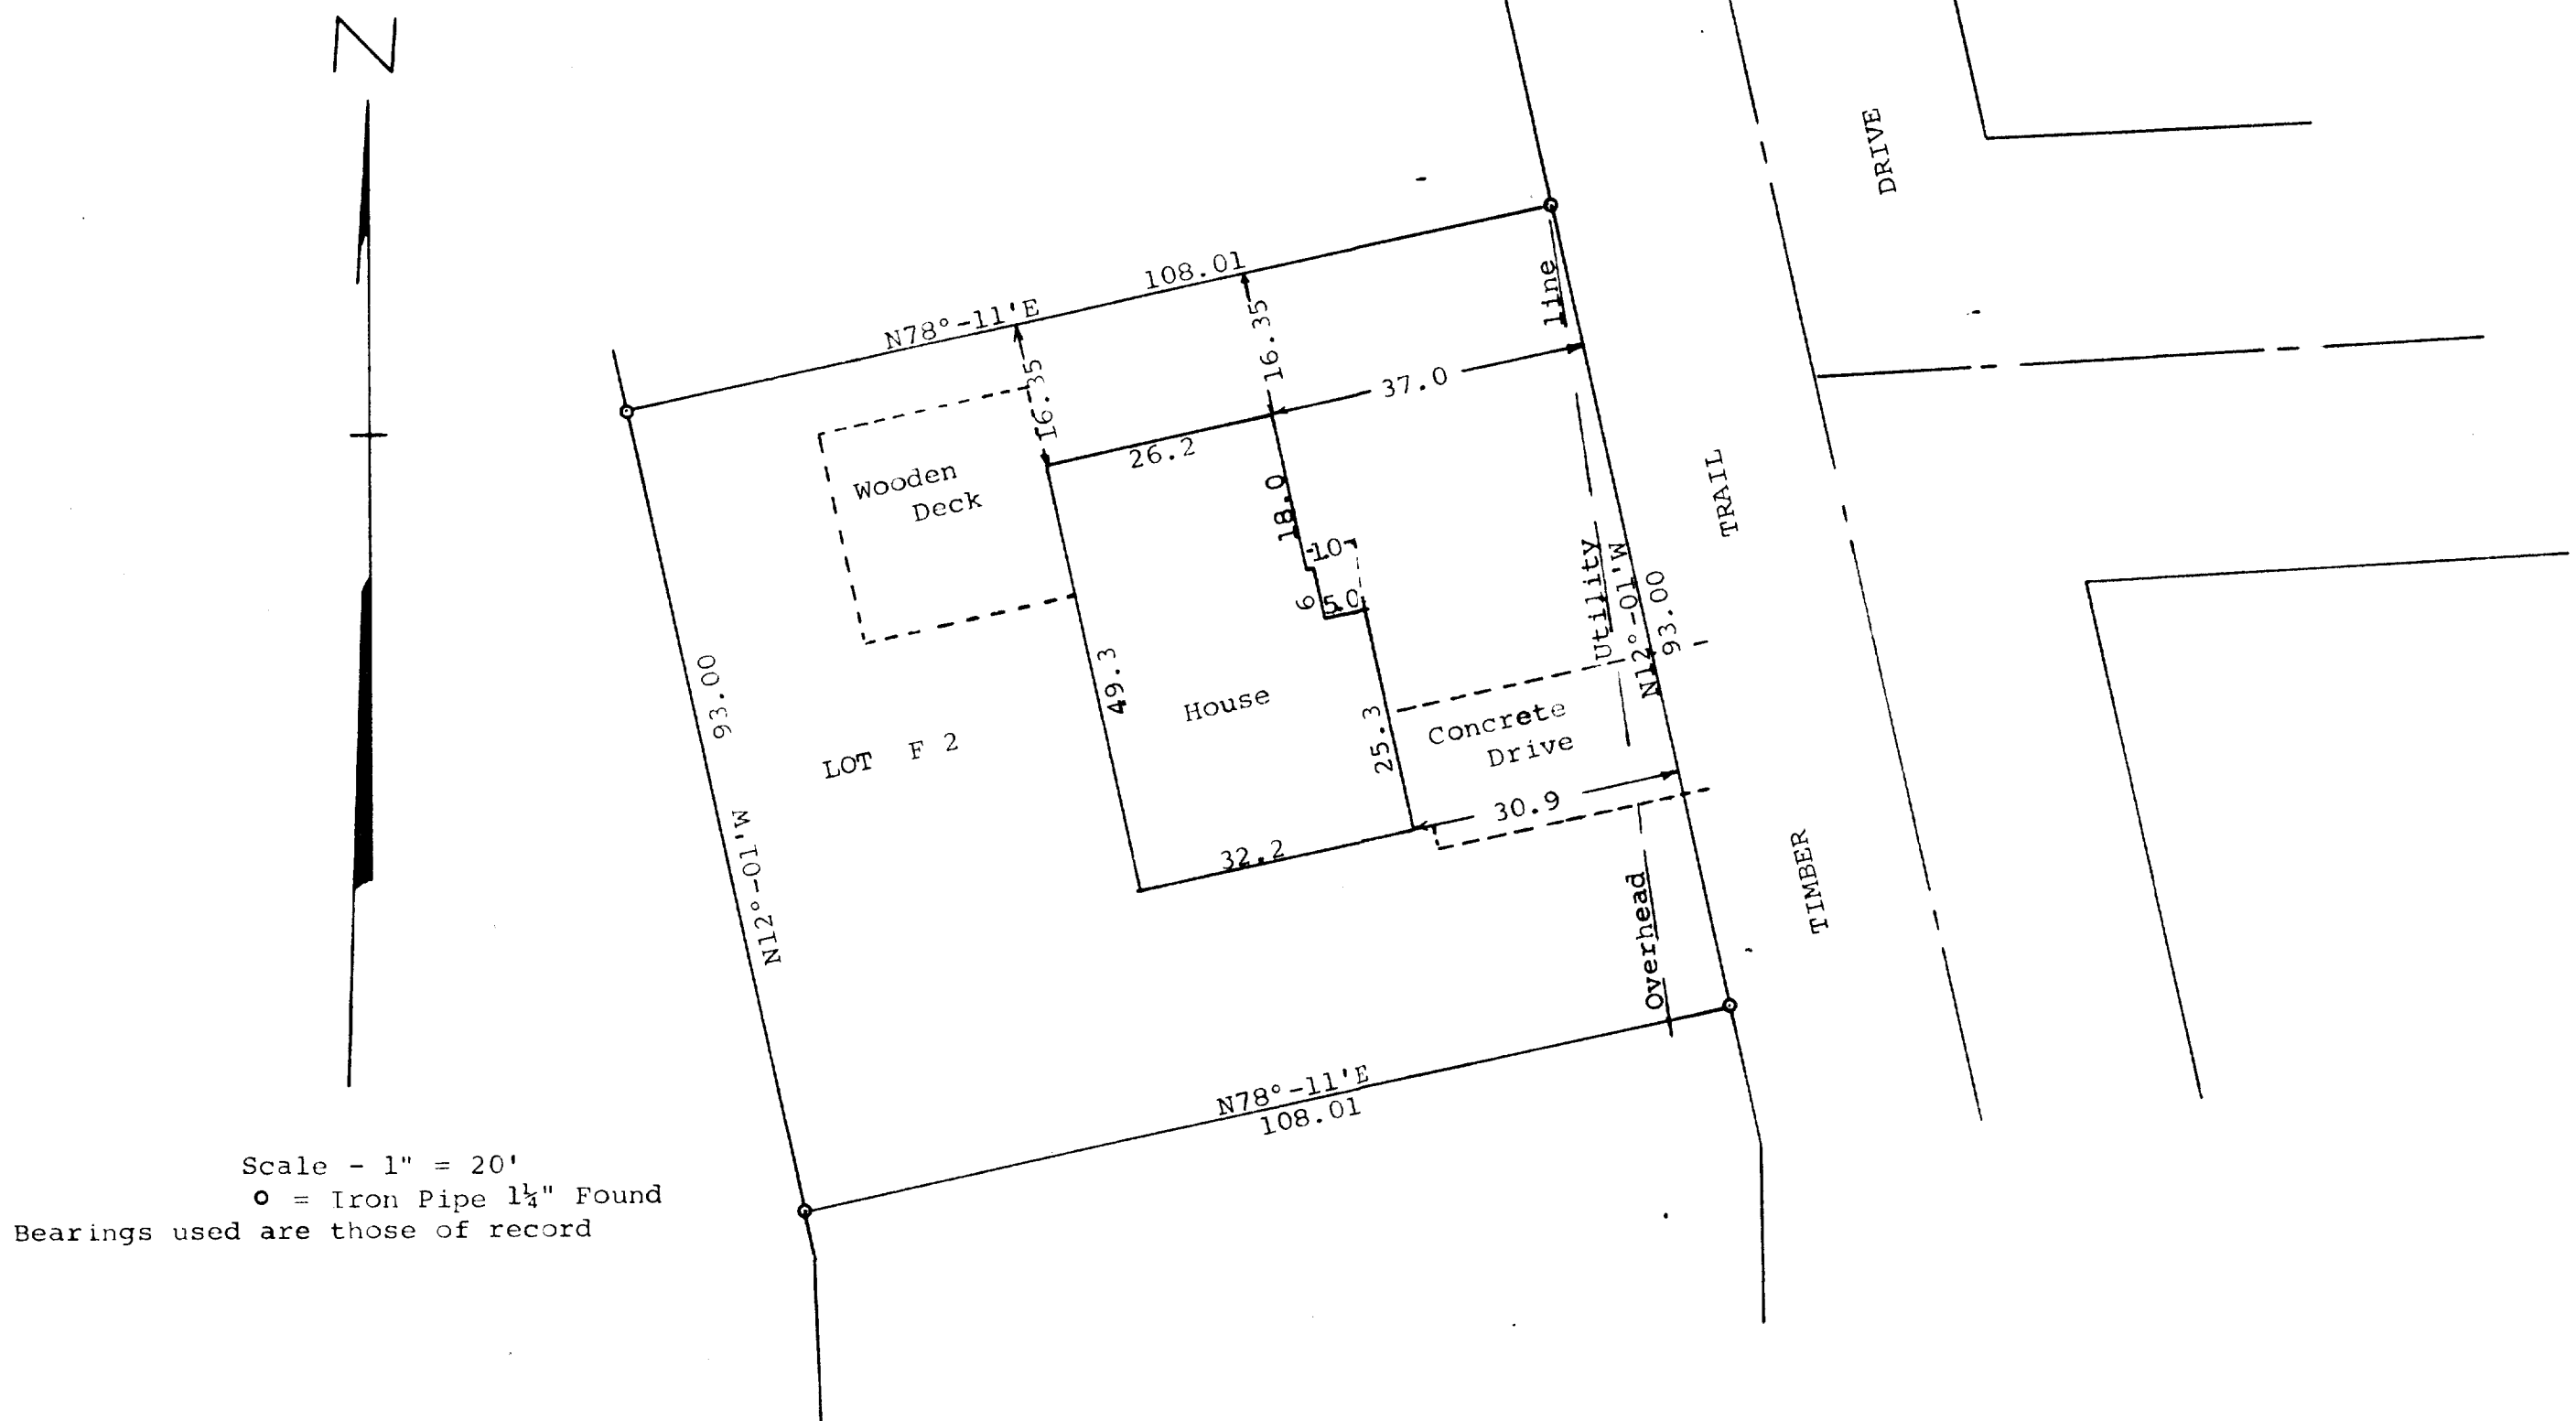


GEORGE T. DUNHAM  
SURVEYING & SUBDIVIDING  
DELAVER, WISCONSIN

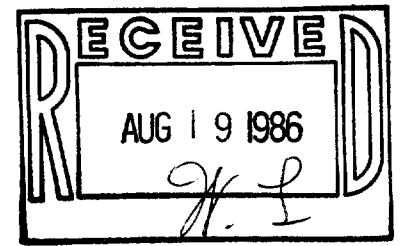

Scale - 1" = 20'  
○ = Iron Pipe 1 1/4" Found  
Bearings used are those of record

STATE OF WISCONSIN) SS  
COUNTY OF WALWORTH)

I, George T. Dunham, Surveyor, certify that I have surveyed the property described as follows, Lot F 2 in Addition F to Country Club Estates located in the Village of Fontana-on-Geneva-Lake, Walworth County, Wisconsin,


and that the above plat is an accurate survey and a true representation thereof and correctly shows the exterior boundary lines and location of buildings on said property and the correct measurements thereof.

August 30, 1971  
Revised Nov. 16, 1982

*George T. Dunham*  
George T. Dunham, Surveyor

I, George T. Dunham, Surveyor certify that I have relocated in iron pipes as shown hereon and that I have surveyed the property hereon described according to the official records, to the best of my knowledge and belief, and that the plat shown hereon is a true representation thereof.

*George T. Dunham*  
George T. Dunham, Surveyor

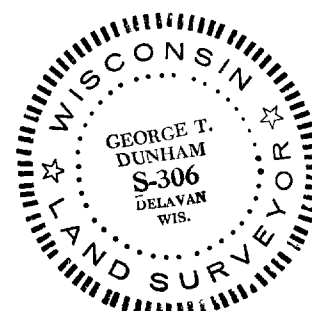

SCTF-00009

5-648-D