

# Farris, Hansen & Associates, Inc.

Engineers, Architects and Surveyors


P.O. BOX 487

7 RIDGEWAY COURT

ELKHORN, WISCONSIN 53121

PLAT OF SURVEY

UNIT II ABBEY SPRINGS CONDOMINIUM  
VILLAGE OF FONTANA-ON-GENEVA LAKE,  
WALWORTH COUNTY, WIS.

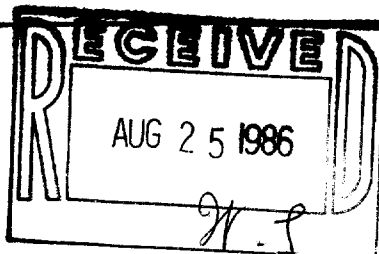

N



NORTH LINE UNIT II  
N 54° 48' E AS RECORDED

POWER & TELETYPE  
JUNCTION BOXES

(197.33')  
197.25'

WATER  
SERVICE  
VALVE

UNIT 10

N 54° 48' E  
1167.25'  
(1167.33')

UNIT II  
VACANT

N 36° 14' W 86.00'

180.0' TO MARK ON END OF CULVERT  
N 58° 25' W 208.88'


UNIT 34

S 42° 29' E 100.00'

18" CULVERT


SEE  
DETAIL

UNIT 12

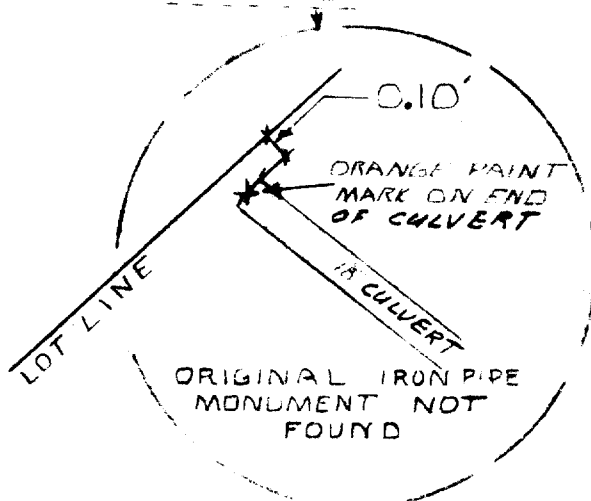

## LEGEND

- Ø = Iron Pipe Survey Stake Found
- O = Iron Pipe Survey Stake Set
- (xxx) = Record Dimension

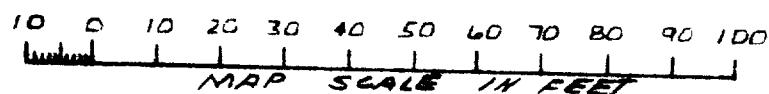

## CERTIFICATE

I hereby certify that the above described property has been surveyed under my direction and that the above map is a true representation thereof and shows the size and location of the property, its exterior boundaries, the location of all visible structures and dimensions of all principal buildings thereon, boundary fences, apparent easements, roadways and visible encroachments, if any.  
This survey is made for the use of the present owners of the property, and also for those who purchase, mortgage, or guarantee the title thereto within one (1) year from the date hereof.

*Robert A. Farris*  
Robert A. Farris, R.L.S.

Dated this 18th day of JULY, 1986

PROJECT NO. Z622