


Farris, Hansen & Associates, Inc.

Engineers, Architects and Surveyors


P.O. BOX 487

7 RIDGEWAY COURT


ELKHORN, WISCONSIN 53121

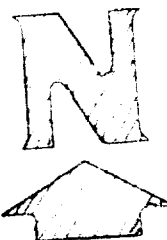

PLAT OF SURVEY LOTS 65 & 66 OF BUENA VISTA
A SUBDIVISION IN THE VILLAGE OF FONTANA, WIS.

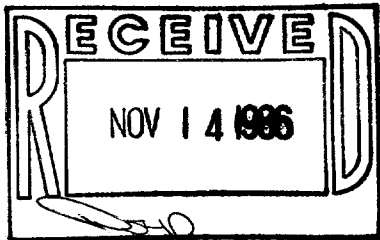

Geneva Fontana Road

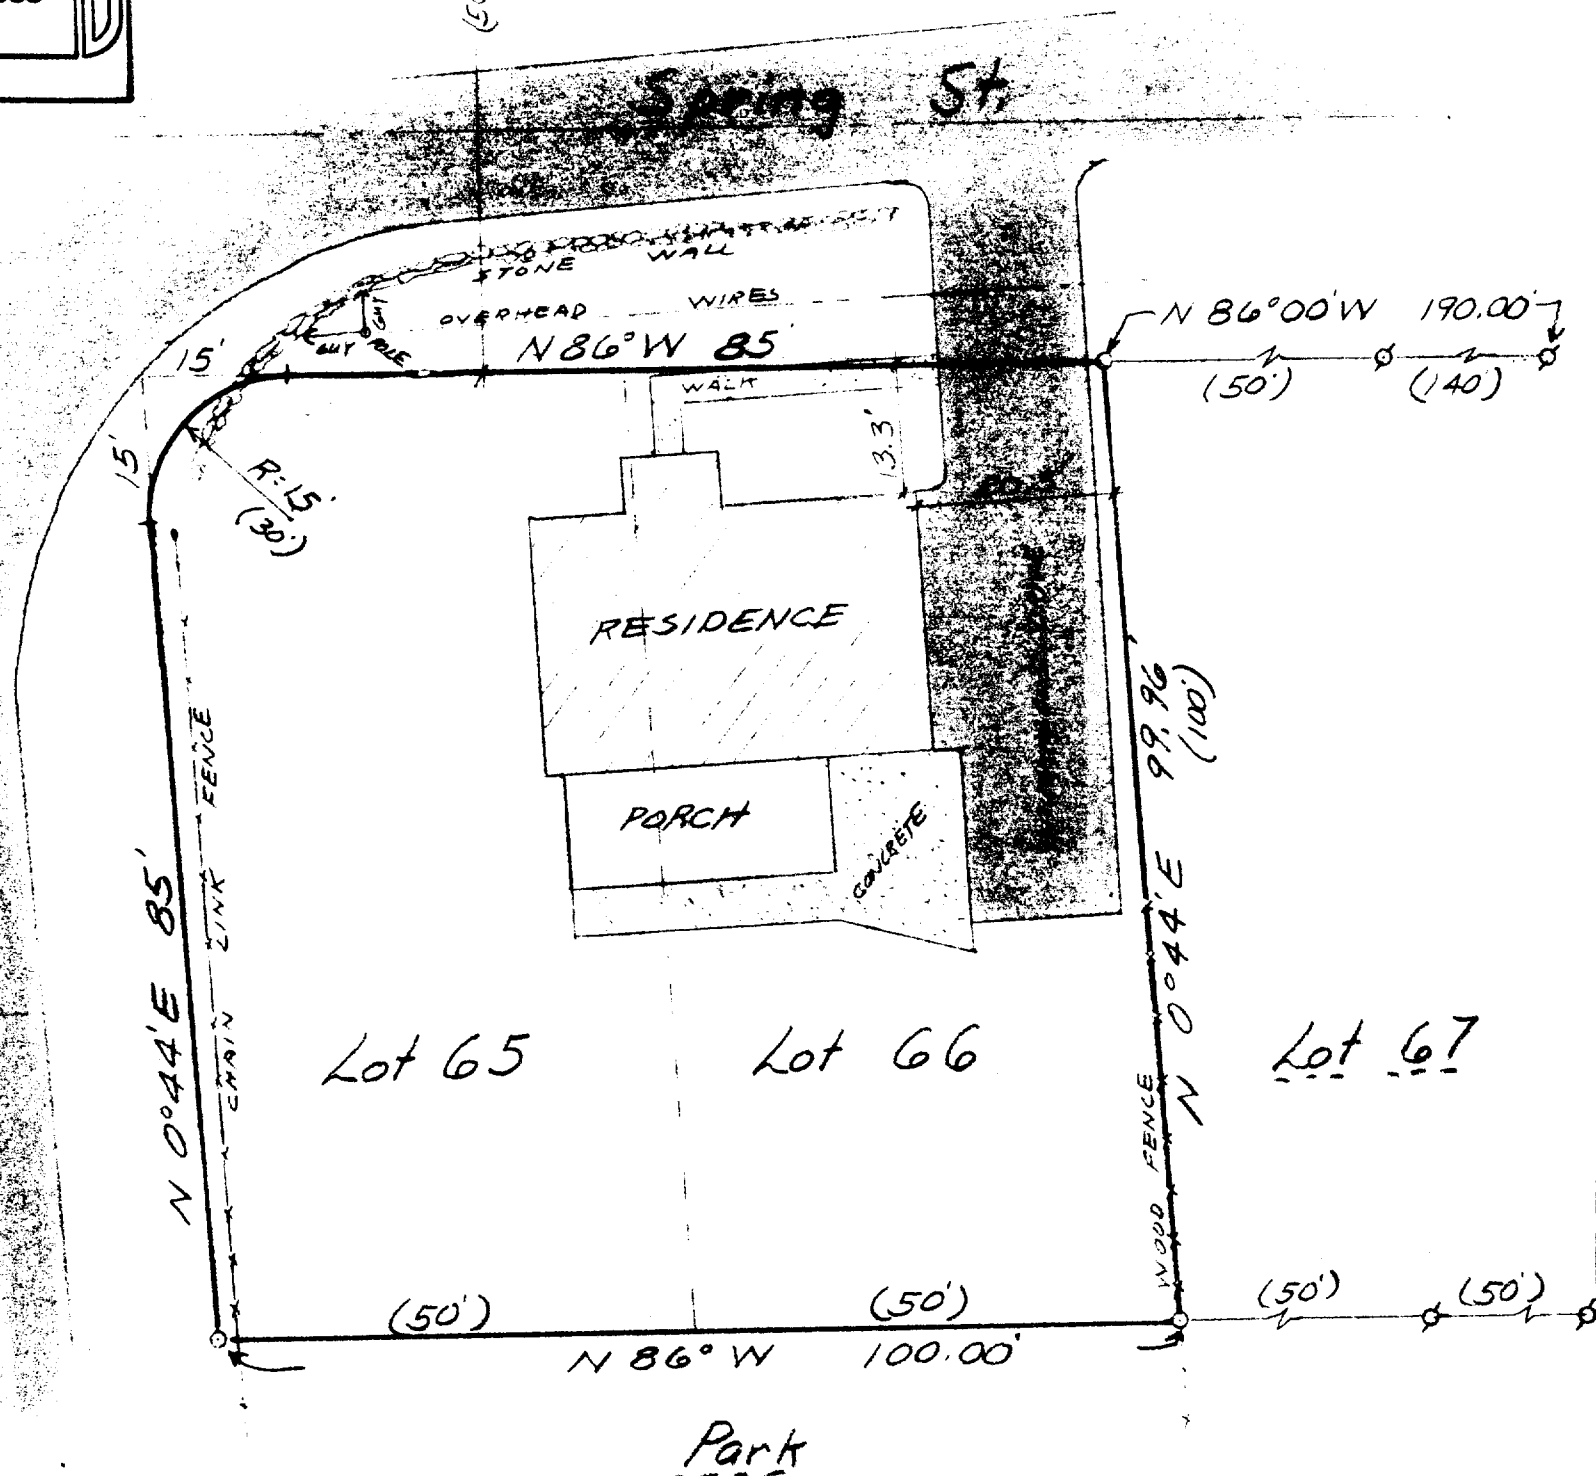

LEGEND

- = Iron Pipe Survey Stake Found
- = Iron Pipe Survey Stake Set
- (xxx) = Record Dimension
- = Iron Rod Survey Stake Set

WORK ORDERED BY:

CORAL O'BRIEN
OAK PARK, IL.

CERTIFICATE

I hereby certify that the above described property has been surveyed under my direction and that the above map is a true representation thereof and shows the size and location of the property, its exterior boundaries, the location of all visible structures and dimensions of all principal buildings thereon, boundary fences, apparent easements, roadways and visible encroachments, if any.
This survey is made for the use of the present owners of the property, and also for those who purchase, mortgage, or guarantee the title thereto within one (1) year from the date hereof.

Robert A. Farris
Robert A. Farris, R.L.S.

Dated this 30 day of OCT., 1986

PROJECT NO. 2684

5676