
WALWORTH COUNTY SURVEYING & MAPPING LAKE GENEVA, WISCONSIN

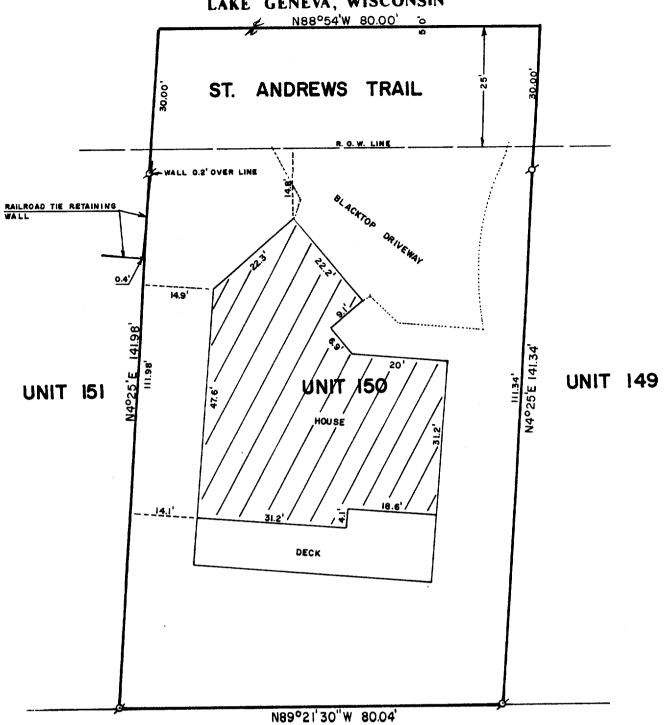

GOLF COURSE

ECEIVE

PLAT OF SURVEY OF

UNIT 150 OF ABBEY SPRINGS, LOCATED IN THE VILLAGE OF FONTANA-ON-GENEVA LAKE, WALWORTH COUNTY, WISCONSIN.

> ORDERED BY: KEEFE REAL ESTATE P. O. BOX 268 WALWORTH, WISCONSIN



SCALE: 1"=20'

ø -IRON PIPE FOUND

I, ROBERT M. BAERENWALD, DO HEREBY CERTIFY THAT I HAVE SURVEYED THE PROPERTY HEREON DESCRIBED ACCORDING TO THE OFFICIAL RECORDS AND THAT THE PLAT HEREON IS A CORRECT REPRESENTATION OF THE PROPERTY LINES TO THE BEST OF MY KNOWLEDGE AND BELIEF.

MINNE ROBERT M. BAERENWALD

WISCONSIN REGISTERED LAND SURVEYOR, S-1508

JOB NO. 0871

NOTE: THIS IS NOT A CERTIFIED COPY UNLESS SEALED.

SCDB4-150